FORM 5I 10M 8-47

KANSAS


Finney

Section 27 Township 21 Range 34W

Well No. #3 Nunn

Company Shallow Water Ref.

Nunn Pool

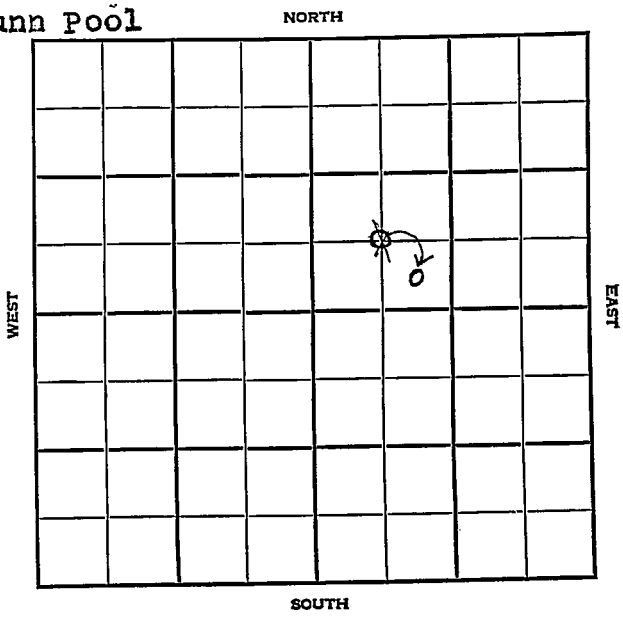

FORM 252-A
5M 9-47 PETROL

KANSAS Finney

Sec. 27 Twp. 21 R. 34W

Well No. #3 Nunn Farm

Shallow Water Ref. Company

Nunn Pool


Ft. from N. Line

330' / 660 Ft. from S. Line

Ft. from E. Line

990' / 660 Ft. from W. Line

~~C SW NE~~
SE SW NE

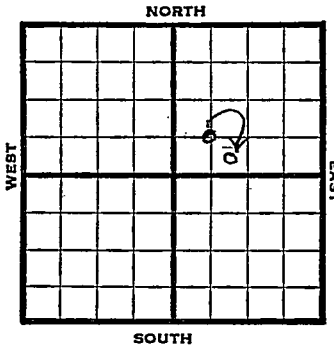

	Elev. 2956' REPORT
~~1947~~	
10/29	Location
11/5	Surface Hole
11/12	10" @ 286' Drlg. 2080'
11/19	Drlg. 3890'
11/25	Drlg. 4390'
12/3	Lansing 3851' Mississippi 4607' TD 4624' 5" @ 4610' RUST
12/10	"
12/17	TD 4646' Fsg. Liner
1948	
1/7	Miss. 4607' 5" @ 4610' 2000 Acid... Pump 841 Pot. Gr. 27° Total Depth 4707' COMPLETED

Form 26 200 Bks. 10-46 Petrol

Nunn Pool

Kansas

Map No. _____ Sec. 27 Twp. 21 R. 34W


Well No. 3 Nunn

Shallow Water Ref. Company

FIRST REPORT Contractor

C SW NE

SECTION PLAT

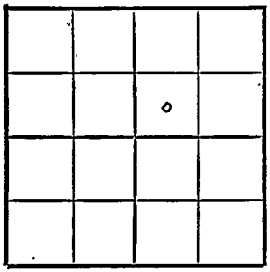

_____ Ft. from N. Line

660 Ft. from S. Line

_____ Ft. from E. Line

660 Ft. from W. Line

Finney County

Location x

Rig up

Drilling and Remarks:

RECORD

Cased _____ in., _____ ft.

Sand

Gas

Oil

Total Depth

PRODUCTION

1st 24 hrs. Nat.

1st 24 hrs. after shot

Gas _____ Cu. Ft.

Dry Hole

Abandoned

Date

OCT 2 9 1947 19 S. J. LEWIS Scout

Form 26 200 Bks. 10-46 Petrol

Kansas

Nunn Pool

Map No. ____ Sec. 27 Twp. 21 R. 34W


Well No. 3 Nunn

Shallow Water Ref. Company

CORRECTION Contractor

SE SW NE

SECTION PLAT

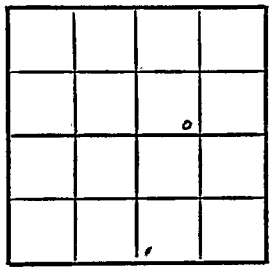

____ Ft. from N. Line

330 Ft. from S. Line

____ Ft. from E. Line

990 Ft. from W. Line

FINNEY Co (old)

Location

Rig up

Drilling and Remarks:

reported
e sw ne

RECORD

Cased ____ in., ____ ft.

Sand

Gas

Oil

Total Depth

PRODUCTION

1st 24 hrs. Nat.

1st 24 hrs. after shot

Gas ____ Cu. Ft.

Dry Hole

Abandoned

Date

NOV 5 1947 19

S. J. LEWIS Scout

Form 26 200 Bks. 10-46 Petrol.

Nunn Pool

Kansas

Map No. O Sec. 27 Twp. 21 R. 34W

Well No. 3 Nunn


Shallow Water Ref. Company

COMPLETE Contractor

SE SW NE

E. 2956

SECTION PLAT

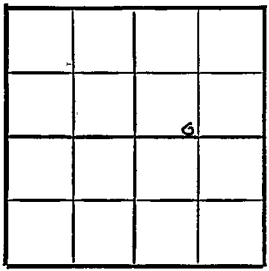

____ Ft. from N. Line

330 Ft. from S. Line

____ Ft. from E. Line

990 Ft. from W. Line

Finney County

Location

Rig up

Drilling and Remarks:

Miss 4607

5" @ 4610

2000 and O

Perf 5 SNP-X

27 & Gr

RECORD

Cased ____ in., ____ ft.

Sand

Gas

Oil

Total Depth 4707

PRODUCTION

1st 24 hrs. Nat.

1st 24 hrs. after shot.

Gas ____ Cu. Ft.

Dry Hole

Abandoned

Date

JAN 7 1948 19

S. J. LEWIS Scout