


Section 27 Township 21 Range 34W

Well No. 4 Nunn

Company Shallow Water Ref.

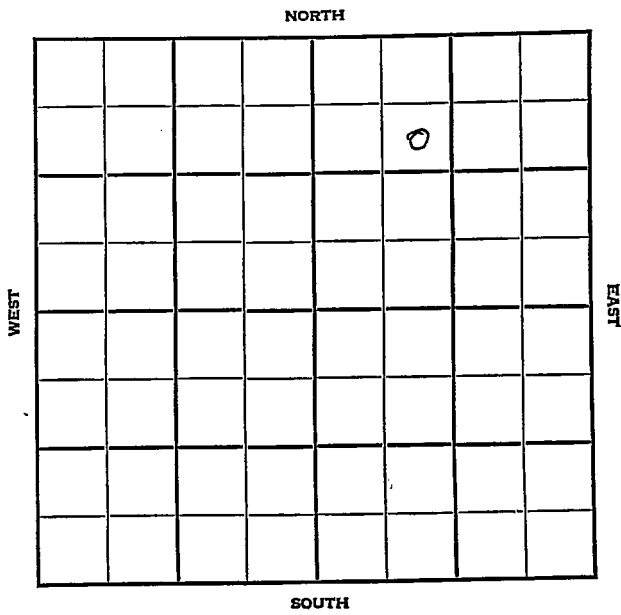


Sec. 27 Twp. 21 R. 34WWell No. #4 Nunn FarmShallow Water Ref. Company

Nunn

990 Ft. from N. Line Ft. from S. Line Ft. from E. Line990 Ft. from W. Line

SE NW NE

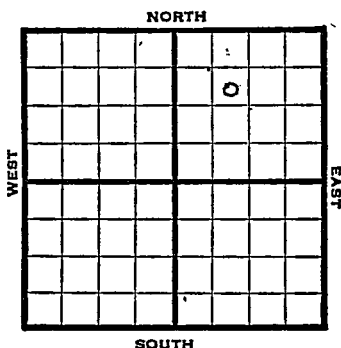

1947

Elev. 2960' REPORT

12/30 Surface hole.

1948

1/7

Drlg. 2560'

1/14

10" @ 280'

Drlg 3952'

1/21

Drlg. 4530'

1/26

Mississippi 4611'

TD 4660'

5" @ 4659'

RUST

2/4

"

2/11

TD 4725' - 1000 acid.

2/18

"

2/25

"

3/3

TD 4742'

5000 Acid

No oil

3/10

"

3/17

Miss. 4611'

5" @ 4659'

1600 Acid

Pump 602 Pot.

Gr. 27°

TD 4725'

COMPLETED

Map No. _____ Sec. 27 Twp. 21 R. 34W

Well No. 4 Nunn

Shallow Water Ref. _____ Company

FIRST REPORT

Contractor _____

SE NW NE

SECTION PLAT

		a	

990 Ft. from N. Line

_____ Ft. from S. Line

_____ Ft. from E. Line

990 Ft. from W. Line

Finney County

Location _____

Rig up _____

Drilling and Remarks:

surface hole

RECORD

Cased _____ in., _____ ft.

Sand _____

Gas _____

Oil _____

Total Depth _____

PRODUCTION

1st 24 hrs. Nat. _____

1st 24 hrs. after shot _____

Gas _____ Cu. Ft.

Dry Hole _____

Abandoned _____

Date

DEC 30 1947

19

S. J. LEWIS

Scout

No Map
Map No. _____ Sec. 27 Twp. 21 R. 34W

Well No. 4 Nunn

Shallow Water Ref. _____ Company _____

COMPLETE

SE NW NE

Contractor

E1.2960

SECTION PLAT

990 Ft. from N. Line

_____ Ft. from S. Line

_____ Ft. from E. Line

990 Ft. from W. Line

Finney County

Location _____

Rig up _____

Drilling and Remarks:

Mis 4611

5' 4658

10000 cu ft

Per 602 BX

27 28

RECORD

Cased _____ in., _____ ft.

Sand _____

Gas _____

Oil _____

Total Depth 4725

PRODUCTION

1st 24 hrs. Nat. _____

1st 24 hrs. after shot _____

Gas _____ Cu. Ft.

Dry Hole _____

Abandoned _____

Date

MAR 17 1948

19

S. J. LEWIS

Scout