

KANSAS


Finney Cour

Section 27 Township 21 Range 34W

Well No. 6 Nunn

Company Shallow Water Ref.

Nunn Pool

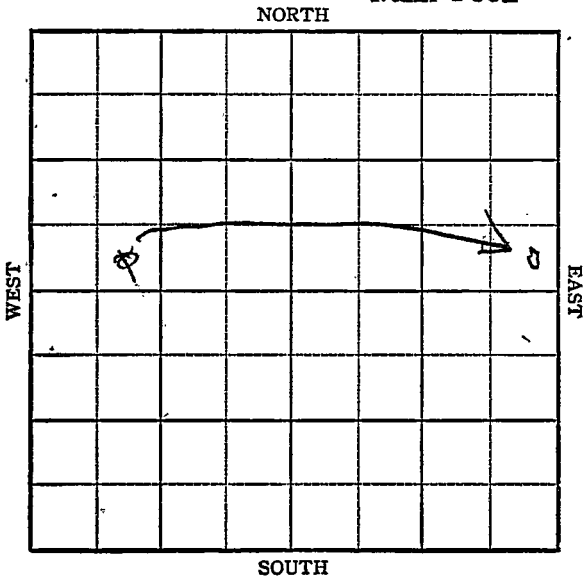

Sec. 27 Twp. 21 R. 34W

Well No. #6 Nunn Farm

Shallow Water Ref. Company

Nunn Pool

 Ft. from N. Line


330' Ft. from S. Line

330' Ft. from E. Line

990' Ft. from W. Line

SE NW

~~SE~~ ~~SW~~ ~~NW~~

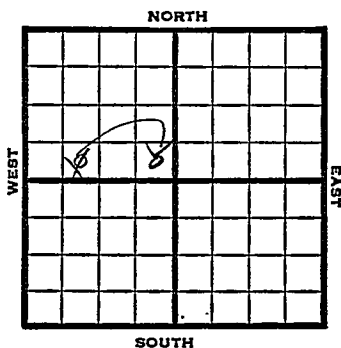

1948

Eli 2958

R E P O R T

10/20

Location

10/26

10" @ 256'

Drlg. 3000'

11/3

Drlg 4151'

11/10

Drlg 4509'

11/16

TD 4646'

5" @ 4616'

11/23

"

11/30

"

12/6

"

12/14

Miss 4611'

TD 4725'

12/22

11,000 acid

Pump 75 bbls oil a day

12/29

"

1/5

"

1/12

"

1/19

TD 4725'

Miss 4611'

5" @ 4616'

11000 acid

Pump 646 Oil + 10% W Pot

31° Gr.

Comp

COMPLETED

*Trt. ret for. Correction
in Location 1-21-49*

Map No. _____ Sec. 27 Twp. 21 R. 34W

Well No. 6 Nunn

Shallow Water Ref. _____

Company _____

FIRST REPORT

Contractor _____

SE SW NW


SECTION PLAT

_____ Ft. from N. Line

330 Ft. from S. Line

_____ Ft. from E. Line

990 Ft. from W. Line

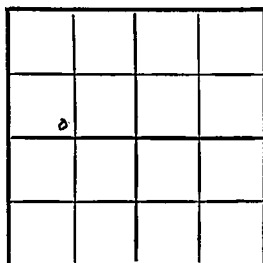

Finney County

Location X

Rig up _____

Drilling and Remarks:

RECORD

Cased _____ in., _____ ft.

Sand _____

Gas _____

Oil _____

Total Depth _____

PRODUCTION

1st 24 hrs. Nat. _____

1st 24 hrs. after shot _____

Gas _____ Cu. Ft.

Dry Hole _____

Abandoned _____

Date

OCT 20 1948 19

S. J. LEWIS

Scout

Map No. _____ Sec. 27 Twp. 21 R. 34W

Well No. 6 Nunn

Shallow Water Ref. _____ Company

CORRECTION _____ Contractor

SE NW


SECTION PLAT

_____ Ft. from N. Line

330 _____ Ft. from S. Line

330 _____ Ft. from E. Line

_____ Ft. from W. Line

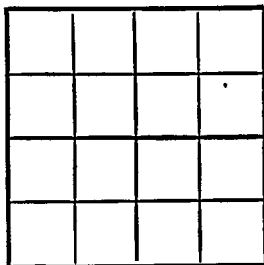

Finney County

Location _____

Rig up _____

Drilling and Remarks:

Reported

SE SW NW

RECORD

Cased _____ in., _____ ft.

Sand _____

Gas _____

Oil _____

Total Depth _____

PRODUCTION

1st 24 hrs. Nat. _____

1st 24 hrs. after shot _____

Gas _____ Cu. Ft.

Dry Hole _____

Abandoned _____

Date

JAN 26 1949 19

S. J. LEWIS Scout

Kansas

Nunn Pool

Map No. _____ Sec. 27 Twp. 21 R. 34WWell No. 6 Nunn


Shallow Water Ref. _____

Company _____

COMPLETE

Contractor _____

SE NW

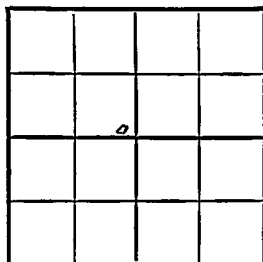E. 1.2958
SECTION PLAT

_____ Ft. from N. Line

330 Ft. from S. Line330 Ft. from E. Line

_____ Ft. from W. Line

Finney County

Location _____

Rig up _____

Drilling and Remarks: _____

*Miss 4611**5" @ 4616**11000 Acad**Pony 646 oil + 10%**H.P.T.**312 1/2*

RECORD

Cased _____ in., _____ ft.

Sand _____

Gas _____

Oil _____

Total Depth 4725

PRODUCTION

1st 24 hrs. Nat. _____

1st 24 hrs. after shot _____

Gas _____ Cu. Ft.

Dry Hole _____

Abandoned _____

Date

JAN 19 1949

19

S. J. LEWIS

Scout