
FORM 51 10M 8-47

KANSAS
Finney

Section 27 Township 21 Range 34-W

Well No. #5 Nunn

Company Shallow Water Ref.

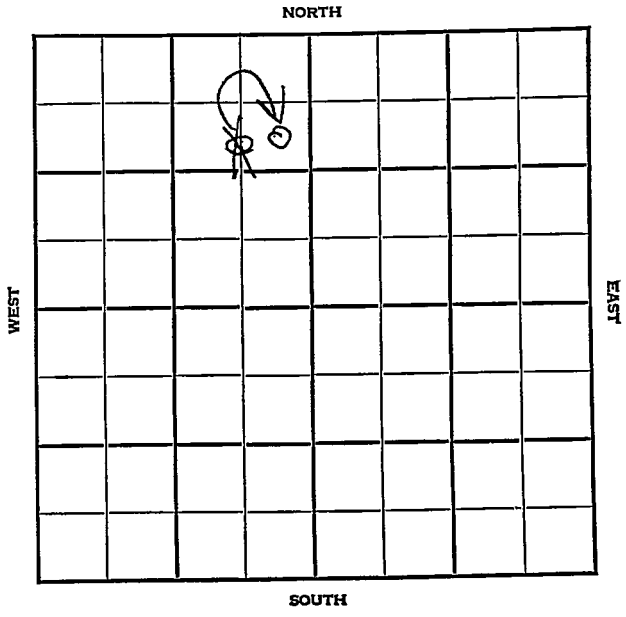

FORM 252-A
5M 4-48 PETROL

KANSAS Finney

Sec. 27 Twp. 21 R. 34W

Well No. #5 Nunn Farm

Shallow Water Ref. Company

Nunn Pool

990' Ft. from N. Line


Ft. from S. Line

~~660'~~ 330' Ft. from E. Line

Ft. from W. Line

~~C~~ ~~S~~ ~~L~~ ~~NE~~ ~~NW~~

SE NE NW

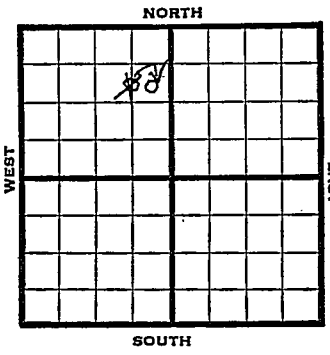

1948	REPORT
	Eli 2960'
6/16	Surface Hole
6/23	"
6/29	"
7/8	"
7/14	"
7/21	"
7/28	SD
8/4	8" @ 261' Drlg. 2250'
8/11	Drlg 3859'
8/18	Mississippi 4616' Drlg 4632'
8/25	TD 4720' 5"@ 4490'
9/1	"
9/8	48 shots 4301-09 6000 acid 3000' oil
9/15	Miss 4616' 5"@ 4490' Td 4720' 6000 acid 1260 Butane Pump 652' oil Pot 31° Gr. Comp COMPLETED

Form 26—200 Bks.—1-48—Palace

Nunn Pool

Kansas

Map No. _____ Sec. 27 Twp. 21 R. 34W

Well No. 5 Nunn

Shallow Water Ref. Company

FIRST REPORT Contractor

C S L NE NW


990 Ft. from N. Line

_____ Ft. from S. Line

660 Ft. from E. Line

_____ Ft. from W. Line

SECTION PLAT

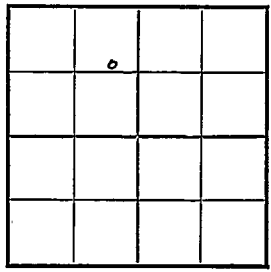

Finney County

Location _____

Rig up _____

Drilling and Remarks:

surface hole

RECORD

Cased _____ in., _____ ft.

Sand _____

Gas _____

Oil _____

Total Depth _____

PRODUCTION

1st 24 hrs. Nat. _____

1st 24 hrs. after shot _____

Gas _____ Cu. Ft.

Dry Hole _____

Abandoned _____

Date

JUN 16 1948 19____ S. J. LEWIS Scout

Form 26—200 Bks.—1-48—Palace

Nunn Pool

Kansas

Map No. ____ Sec. 27 Twp. 21 R. 34W

Well No. 5 Nunn

Shallow Water Ref. Company

CORRECTION

Contractor

SE NE NW


990 Ft. from N. Line

____ Ft. from S. Line

330 Ft. from E. Line

____ Ft. from W. Line

SECTION PLAT

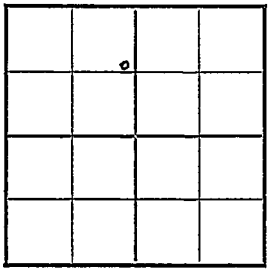

Finney County

Location

Rig up

Drilling and Remarks:

Reported

C S L NE NW

RECORD

Cased ____ in., ____ ft.

Sand

Gas

Oil

Total Depth

PRODUCTION

1st 24 hrs. Nat.

1st 24 hrs. after shot

Gas ____ Cu. Ft.

Dry Hole

Abandoned

Date

JUN 30 1948 19

S. J. LEWIS Scout

Form 27—100 Bks.—4-48—Petrol

Finney County Kansas State

Map No. Sec. 27 Twp. 21 R. 34W

Well No. 5 Nunn


Shallow Water Ref. Company

COMPLETE Contractor

SE NE NW

E 1,2960

SECTION PLAT

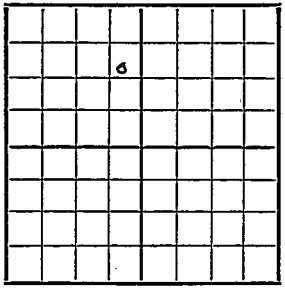

990 Ft. from N. Line

Ft. from S. Line

330 Ft. from E. Line

Ft. from W. Line

Nunn Pool

Remarks:

Miss 4616

5" @ 4490

TD 4720

6000 Acid

1260 Butane

Prod 652 oil Bbls.

31° Gr

Date SEP 15 1948

Scout S. J. LEWIS