


KANSAS Finney

Section 27 Township 21 Range 34WWell No. 7 NunnCompany Shallow Water Ref.

Nunn Pool

NORTH

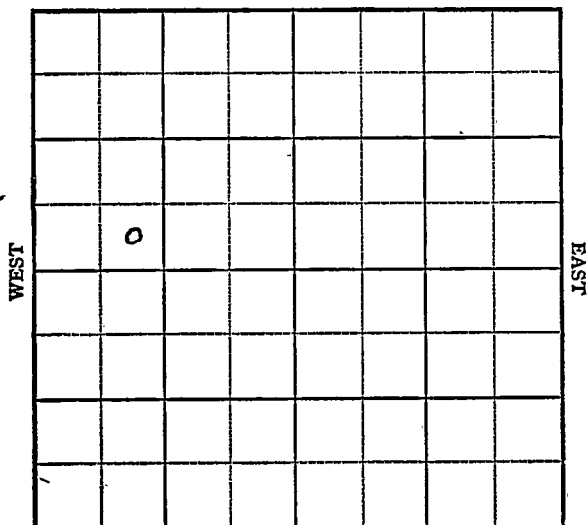

SOUTH

Sec. 27 Twp. 21 R. 34W ✓

Well No. 7 Nunn Farm

Shallow Water Ref. Company

Nunn Pool


 Ft. from N. Line

330 Ft. from S. Line

 Ft. from E. Line

990 Ft. from W. Line

SE SW NW

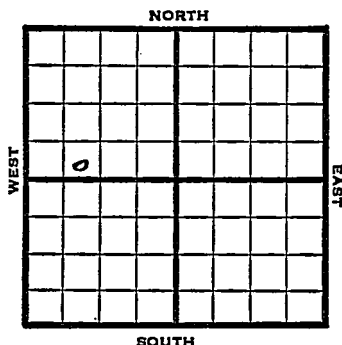

1948	Elev. 2959' REPORT
11/17	8" @ 245'
11/23	"
11/30	Dr1g 3990'
12/6	Dr1g. 4536'
12/14	TD 4736'
	5" @ 4632'
12/22	Miss 4626'
	TD 4736'
12/29	"
1/5	"
1/12	"
1/19	"
1/26	Miss 4626'
	5" @ 4632' ⁴³⁰⁴⁻¹⁶
	144 shots 434-16
	5000 acid
	Formation 4237?
	Pump 877 Oil Pot.
	Gr. 31°
	TD 4736'
	COMPLETED

Map No. _____ Sec. 27 Twp. 21 R. 34W

Well No. 7 Nunn

Shallow Water Ref. _____ Company _____

FIRST REPORT Contractor _____

SE SW NW


SECTION PLAT

_____ Ft. from N. Line

330 Ft. from S. Line

_____ Ft. from E. Line

990 Ft. from W. Line

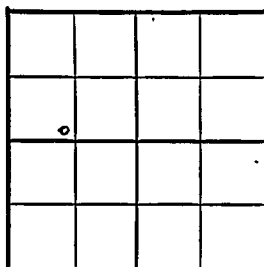

Finney County

Location _____

Rig up _____

Drilling and Remarks:

8" @ 245

RECORD

Cased _____ in., _____ ft.

Sand _____

Gas _____

Oil _____

Total Depth _____

PRODUCTION

1st 24 hrs. Nat. _____

1st 24 hrs. after shot _____

Gas _____ Cu. Ft.

Dry Hole _____

Abandoned _____

Date

NOV 17 1948

19

S. J. LEWIS Scout

Map No. _____ Sec. 27 Twp. 21 R. 34W

Well No. 7 Nunn

Shallow Water Ref. _____


Company _____

COMPLETE

Contractor _____

SE SW NW

B. 2957
SECTION PLAT

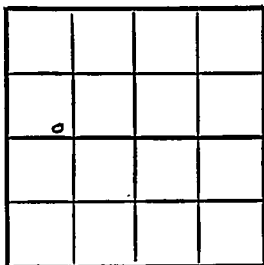

_____ Ft. from N. Line

330 Ft. from S. Line

_____ Ft. from E. Line

990 Ft. from W. Line

Finney County

Location _____

Rig up _____

Drilling and Remarks:

Misc 4626
5" @ 4632
144 slt to 4304-16.
5-000 acid
Harm to 4237
Pump 877 oil

RECORD

Cased _____ in., _____ ft.

Sand _____

Gas _____

Oil _____

Total Depth 4236

PRODUCTION

1st 24 hrs. Nat. _____

1st 24 hrs. after shot _____

Gas _____ Cu. Ft.

Dry Hole _____

Abandoned _____

Date

21st

JAN 26 1949

19

S. I. LEWIS

Scout