


Section 27 Township 21 Range 35W
Well No. 1 McNellis 21 ~~35W~~
Company Nate Appleman

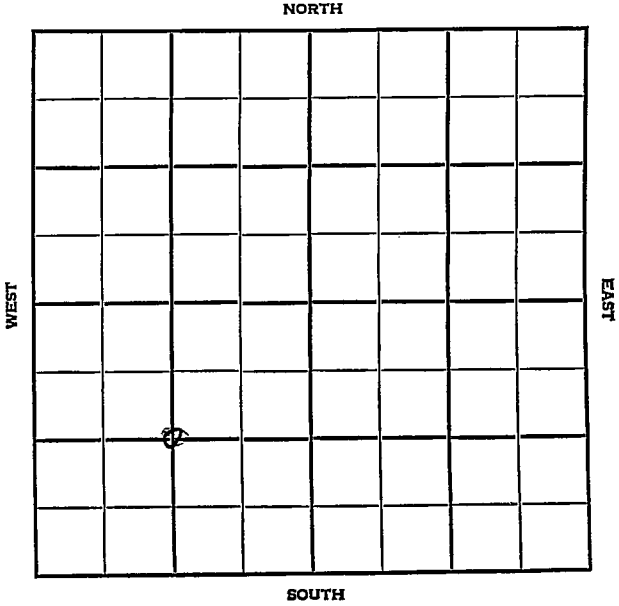

Kearny

KANSAS

SEC.	TWP.	R.
27	21	35 W ✓

WELL NO.

1 McNellis

FARM

COMPANY

Nate Appleman

CONTRACTOR

Hugoton Pool


Ft. from N. Line

1320 Ft. from S. Line

Ft. from E. Line

1320 Ft. from W. Line

C SW/4

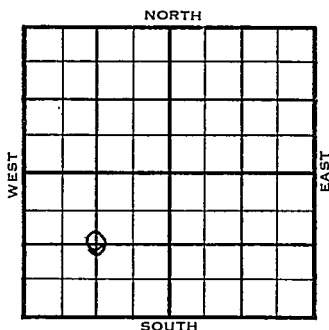

Stanolind Farmout

	ELEVATION	REPORT
1954		
5/26	RUR	
6/2	8" @ 278' w/300 sks RTD 2601' 5" @ 2599'	
6/9	DD 2620' DD 2635' Frac 7 1/2 M gas	
6/23	Spud 5-24-54 Gas well TD 2635' 8" @ 278' TD 2601' 5" @ 2599' DD 2620 DO to 2635' frac er. 2599' Kri. 2623 Comp. 7 MCFGPD	

COMPLETED

County Kearny State KansasSec. 27 (Blk.) 21 (Sur.) 35W Map No.Operator Nate ApplemanWell No. 1 Farm McNellisElev. Location C SW/4

1320 Ft. From S Line SW1320 Ft. From W Line Quarter1st. Report MAY 26 1954


Completion

Remarks Stanolind farmout

Spudding Date

Drlg. Data Hugoton PoolR U R

County Kearny State Kansas
 Sec. 27 (Blk. 21) (Sur. 35W) (Twp.) Map No.
 Operator Nate Appleman
 Well No. 1 Farm McNellis
 Elev. Location C SW/4

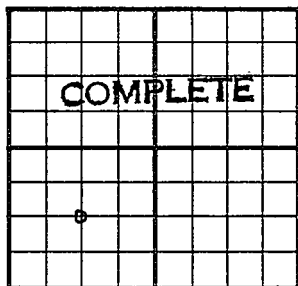

1320 Ft. From S Line SW
1320 Ft. From W Line Quarter
 1st. Report
 Completion JUN 23 1954
 Remarks Hugoton Pool

Spudding Date 5-24-54

Drlg. Data Gas well TD 2635
8" @ 278 TD 2601 5" @ 2599 DD 2620
DO to 2635 frac Her. 2599 Kri. 2623
Comp. 7 mcf/gpd