


Section 28 Township 21 Range 12W

Well No. #1 Sittner

Company Dizdar Investment

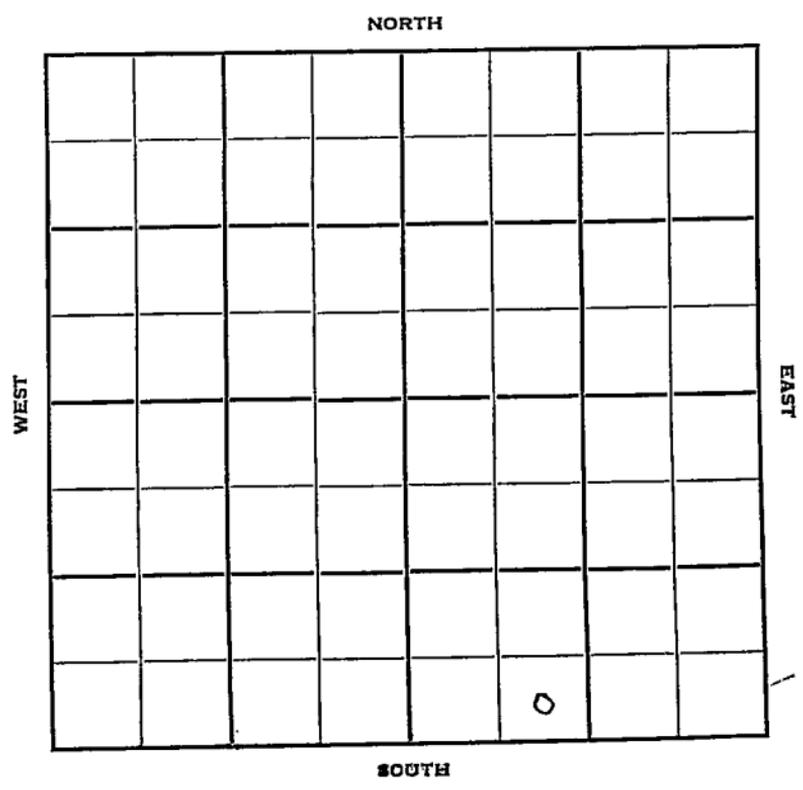

Stafford

KANSAS

Sec. 28 Twp. 21 R. 12 W

Well No. # 1 Sittner Farm

Dizdar Investment Company

Nye Contractor


\_\_\_\_\_ Ft. from N. Line

330 Ft. from S. Line

\_\_\_\_\_ Ft. from E. Line

990 Ft. from W. Line

SE SW SE

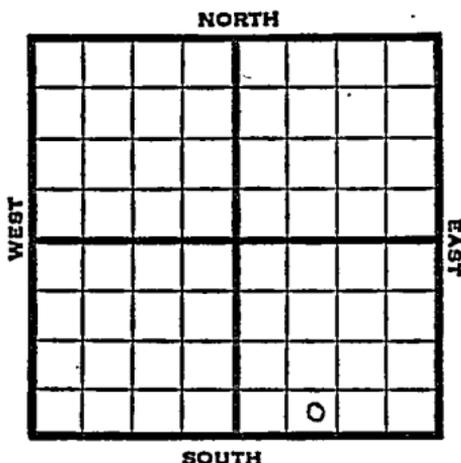

1951

Elev. 1854' REPORT

8/8

Spud 8-5-51  
8" @ 271  
Drlg. 483'

8/29

Spud 8-5-51  
D & A TD 3639' 8" @ 271  
Anhy 650' Br. lime 3254' KC 3269'  
DST 3406-15 open 1/2 hr. rec 30' mud  
Cong. 3520'  
DST 3613-19 open 1/2 hr. rec 30' mud  
Viola 3531' Simp. 3562'  
Simp. sd. 3614' Arb. 3616'  
DST 3621-31 open 1/2 hr. rec 600' SW  
TD 3639' D & A

ABANDONED



