

KANSAS


FORM 51 5M 10-41 PETROL

Stafford

Section 28 Township 21 Range 13-W


Well No. #1 Hufford

Company W. B. Faulkner et al

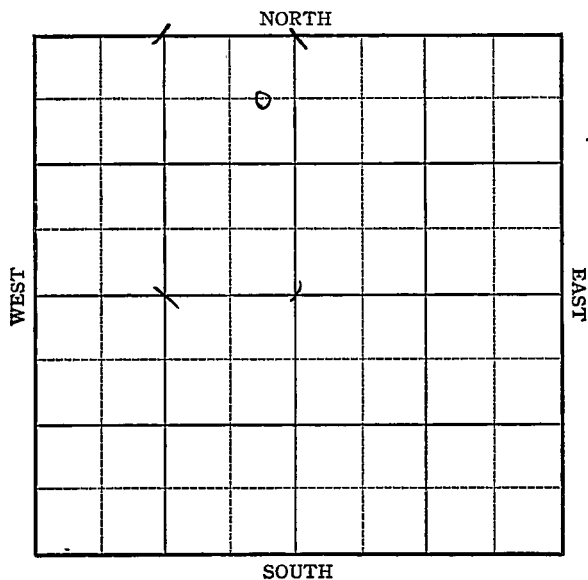

Sec. 28 Twp. 21 R. 13-WWell No. #1 Hofford FarmW. B. Faulkner et al Company

(Hazel)

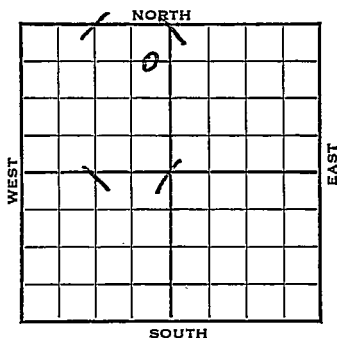660 Ft. from N. Line Ft. from S. Line330 Ft. from E. Line Ft. from W. Line*Elv. 1904*

1942

REPORT

7/15

Rotary.

7/22

10" @ 204

Anhy 785

Drlg. 2220'

7/29

Topeka 2959

Lans. 3364'

B.K.C. 3595

Cong. 3638

Drlg. 3671'

8/5

Simpson 3785'

3806 in Simpson

T.D. 3806'

ABANDONED

Map No. _____ Sec. 21 Twp. 21 R. 13WWell No. 1 HoffordW. B. Faulkner et al. Company

FIRST REPORT

Contractor _____

C EL NE NW


660 Ft. from N. Line

_____ Ft. from S. Line

330 Ft. from E. Line

_____ Ft. from W. Line

SECTION PLAT

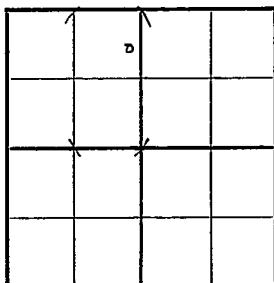

HAZEL POOL

Location _____

Rig up _____

Drilling and Remarks: _____

Rotary

RECORD

Cased _____ in., _____ ft.

Sand _____

Gas _____

Oil _____

Total Depth _____

PRODUCTION

1st 24 hrs. Nat. _____

1st 24 hrs. after shot _____

Gas _____ Cu. Ft.


Dry Hole _____

Abandoned _____

Date

JUL 15 1942 19S. J. LEWIS Scout


 

1 1 v
1 1 1 1 1
1 1 1 1 1

Misc Small Maps
Cards
Tracing
France Map
Scarborough Map
Moody Map
Geological Dept.
Moody Plat Book

Stafford


Map No. 82 Sec. 28 Twp. 21 R. 13WWell No. 1 HuffordW. B. Faulkner et al. Company**CORRECTION**

Contractor

C EL NE NW

660 Ft. from N. Line Ft. from S. Line330 Ft. from E. Line Ft. from W. Line

SECTION PLAT

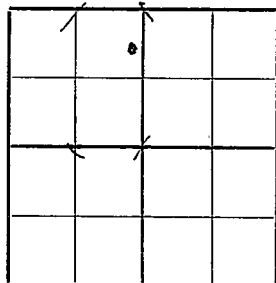

HAZEL POOL

Location Rig up Drilling and Remarks:

Reported as

21-21-13W

RECORD

Cased in., ft.Sand Gas Oil Total Depth

PRODUCTION

1st 24 hrs. Nat. 1st 24 hrs. after shot Gas Cu. Ft.Dry Hole Abandoned

Date

JUL 15 1942

19

S. J. LEWIS

Scout

Misc. Small Maps

Cards

Tracing

France Map

Scarborough Map

Moody Map

Geological Dept.

Moody Flat Book

Stafford

KANSAS

Map No. 82 Sec. 28 Twp. 21 R. 13WWell No. 1 HuffordW. B. Faulkner et al.

Company

ABANDONED

Contractor

C EL NE NW

SECTION PLAT

660 Ft. from N. Line

Ft. from S. Line

330 Ft. from E. Line

Ft. from W. Line

HAZEL POOL

Location

Rig up

Drilling and Remarks:

Simpson 3785
3786 in Simpson

RECORD

Cased _____ in., _____ ft.

Sand _____

Gas _____

Oil _____

Total Depth 3806

PRODUCTION

1st 24 hrs. Nat. _____

1st 24 hrs. after shot _____

Gas _____ Cu. Ft.

Dry Hole _____

Abandoned _____

Date

AUG 5 1942

19

S. J. LEWIS

Scout

Misc. Small Maps

Cards

Tracing

France Map

Scarborough Map

Moody Map

Geological Dept.

Moody Flat Book