

KANSAS

FORM 51 5M 10-41 PETROL


Stafford

Section 28 Township 21 Range 13-W

Well No. #1 P. L. Keenan


Company W. P. Faulkner

Hazel Pool

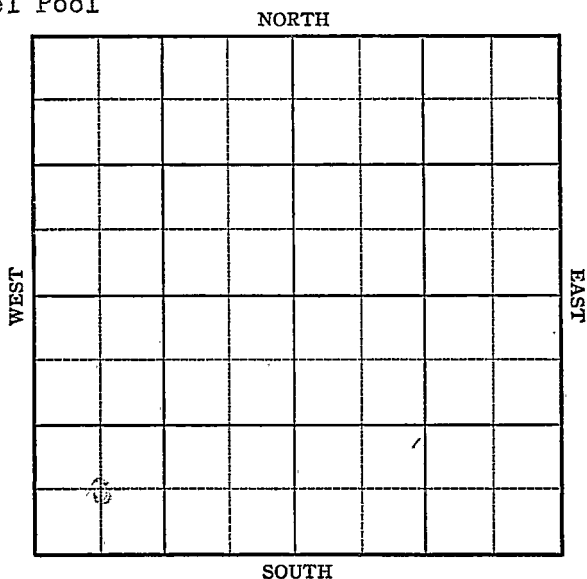

Sec. 28 Twp. 21 R. 13WWell No. 1-P. L. Keenan FarmW. P. Faulkner Company

(Hazel pool)

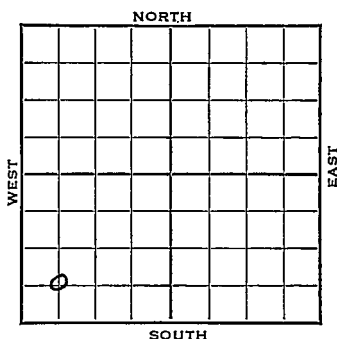 Ft. from N. Line660 Ft. from S. Line Ft. from E. Line660 Ft. from W. Line*Elev. 1903'*

1942

REPORT

9/23

Location

9/30

MIM

10/7

Derrick

10/14

10" @ 153 WOC

10/21

Drlg 2840'

10/28

Lans. 3405'

Viola 3767

Simp 3799

Arb. 3832

No shows

T.D. 3841

ABANDONED

KANSAS

Map No. 82 Sec. 28 Twp. 21 R. 13W

Well No. 1 P. L. Keenan

W. P. Faulkner Company

FIRST REPORT

Contractor

C SW SW

SECTION PLAT

o			

_____ Ft. from N. Line

660 Ft. from S. Line

_____ Ft. from E. Line

660 Ft. from W. Line

HAZEL POOL

Location XXX

Rig up _____

Drilling and Remarks: _____

RECORD

Cased _____ in., _____ ft.

Sand _____

Gas _____

Oil _____

Total Depth _____

PRODUCTION

1st 24 hrs. Nat. _____

1st 24 hrs. after shot _____

Gas _____ Cu. Ft.

Dry Hole _____

Abandoned _____

Date

SEP 23 1942 19 S. J. LEWIS Scout

Map No. 82 Sec. 28 Twp. 21 R. 13WWell No. 1 P. L. KeenanW. P. Faulkner

Company

ABANDONED

Contractor

C SW SW

Ft. from N. Line

660

Ft. from S. Line

Ft. from E. Line

660

Ft. from W. Line

HAZEL POOL

SECTION PLAT

0			

Location

Rig up

Drilling and Remarks:

*Wams 3405**Vesta 3767**Simp 3799**Ag 3832**Noshows*

RECORD

Cased _____ in., _____ ft.

Sand _____

Gas _____

Oil _____

Total Depth 3841

PRODUCTION

1st 24 hrs. Nat. _____

1st 24 hrs. after shot _____

Gas _____ Cu. Ft.

Dry Hole _____

Abandoned _____

Date

OCT 28 1942

19

S. J. LEWIS Scout