

KANSAS


Stafford

Section 28 Township 21 Range 13W

Well No. 1 Sears

Company Berwick, Spurill & ¹¹Harms

Gates Pool

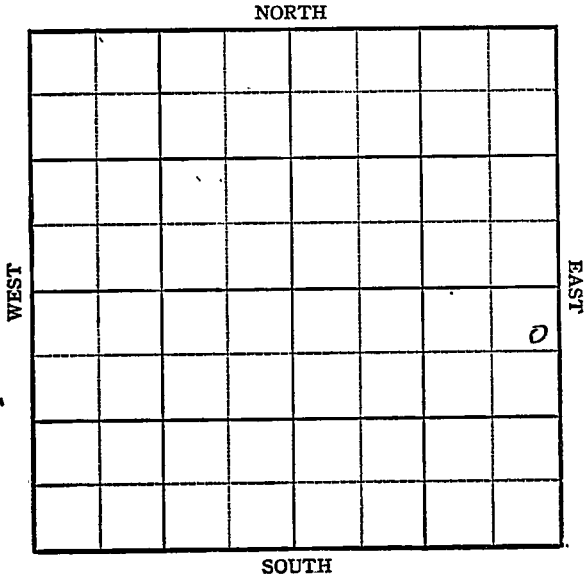

KANSAS

Stafford

Sec. 28 Twp. 21 R. 13W

Well No. #1 Sears Farm

Berwick, Spurill & Harms

Gates Pool Company


500' Ft. from N. Line

Ft. from S. Line

200' Ft. from E. Line

Ft. from W. Line

C E L N E S E

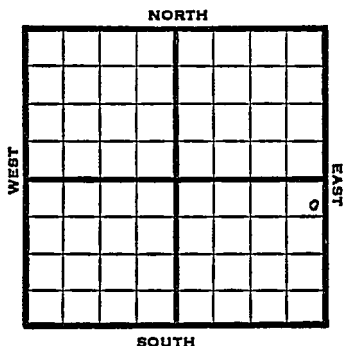

1948

Eli 1888'

R E P O R T

11/10

8" @ 264'

11/16

Lansing 3373'

Drlg. 3404'

11/23

Cong 3624'

TD 3749'

12/1

TD 3749' in Cong

Cong 3624'

Aband.

ABANDONED

Kansas

Gates Pool

Map No. _____ Sec. 28 Twp. 21 R. 13WWell No. 1 Sears

Berwick, Spurill & Harms Company

FIRST REPORT

Contractor

C E L N E S E


SECTION PLAT

500 Ft. from N. Line

_____ Ft. from S. Line

200 Ft. from E. Line

_____ Ft. from W. Line

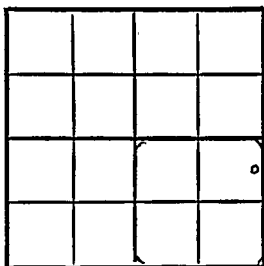

Stafford County

Location _____

Rig up _____

Drilling and Remarks:

8" @ 264

RECORD

Cased _____ in., _____ ft.

Sand _____

Gas _____

Oil _____

Total Depth _____

PRODUCTION

1st 24 hrs. Nat. _____

1st 24 hrs. after shot _____

Gas _____ Cu. Ft.

Dry Hole _____

Abandoned _____

Date

NOV 10 1948 19

S. J. LEWIS

Scout

Map No. 82 Sec. 28 Twp. 21 R. 13W

Well No. 1 Sears

Berwick, Spurill & Harms Company

ABANDONED

Contractor

G E L N E S E


E 1,188
SECTION FLAT

500 Ft. from N. Line

_____ Ft. from S. Line

200 Ft. from E. Line

_____ Ft. from W. Line

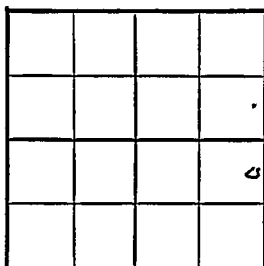

Stafford County

Location _____

Rig up _____

Drilling and Remarks:

Comp 8624

RECORD

Cased _____ in., _____ ft.

Sand _____

Gas _____

Oil _____

Total Depth *2749 in. Comp*

PRODUCTION

1st 24 hrs. Nat. _____

1st 24 hrs. after shot _____

Gas _____ Cu. Ft.

Dry Hole _____

Abandoned _____

Date

DEC 1 1948 19

S. I. LEWIS Scout