

Section 28 Township 21 Range 13 WWell No. # 3 KeneenCompany Petroleum Inc.

NORTH

|   |  |  |  |  |  |  |  |
|---|--|--|--|--|--|--|--|
|   |  |  |  |  |  |  |  |
|   |  |  |  |  |  |  |  |
|   |  |  |  |  |  |  |  |
|   |  |  |  |  |  |  |  |
| 0 |  |  |  |  |  |  |  |
|   |  |  |  |  |  |  |  |
|   |  |  |  |  |  |  |  |
|   |  |  |  |  |  |  |  |

WEST

EAST

SOUTH

Stafford **KANSAS**

Sec. 28 Twp. 21 R. 13W

Well No. #3 Keneen Farm

Petroleum, Inc. Company

Garvey - Contr. Contractor

Hazel Pool


330' Ft. from N. Line

Ft. from S. Line

Ft. from E. Line

330' Ft. from W. Line

NW NW SW

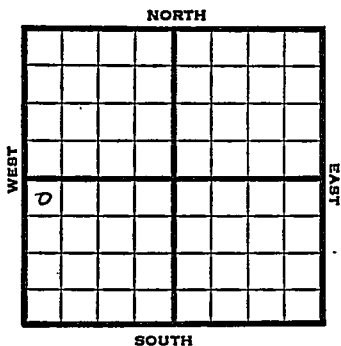

1951

Elev. 1920' REPORT

6/27

Spud 6-23-51

8" @ 221

Drlg. 411

8/15

Spud 6-23-51

Oil Well TD 3778

8" @ 221

Heeb. 3232

Br Lime 3367

Lans. 3378

DST 3390-3410 opn 1 hr

Rec. 45' ocm

DST 3575-3608 opn 45min.

Rec. 30' mud

Cong. 3632 Simp. 3678

Sand 3697 Arb. 3728

DST 3729-33 opn 1 hr

Rec. 420' oil TD 3778

5" @ 3777 18/3729-32 200 A

10 boph Comp. 41 bopd

**COMPLETED**

County **Stafford** State **Kansas**

Sec. 28 (Blk. Twp.) 21 (Sur. Rge.) 13W Map No.

Operator **Petroleum Inc.**

Well No. **3** Farm **Kensen**

| Elev. | Location | NW | NW | SW |
|-------|----------|----|----|----|
|-------|----------|----|----|----|

FIRST REPORT

330 Ft. From N Line SW

330 Ft. From H Line Quarter

1st. Report **JUN 27 1951**

### Completion

Remarks

Garvey - Contr.

Spudding Date **6-23-51**

|            |              |
|------------|--------------|
| Drlg. Data | Hazel - Pool |
|------------|--------------|

8<sup>u</sup> @ 221 Drig. 411

J. E. TYRA

County Stafford State Kansas

Sec. 28 (Blk.) 21 (Sur.) 13W Map No.

Operator Petroleum Inc.

Well No. 3 Farm Keenan

| Elev. | 1920 | Location | NW | NW | SW |
|-------|------|----------|----|----|----|
|-------|------|----------|----|----|----|

[illegible]

330 Ft. From N Line SW

330 Ft. From W Line Quarter

1st. Report

Completion **AUG 15 1951**

Remarks Hazel Pool

Garvey Oil - Contr.

Spudding Date 6-23-51

Drlg. Data      Oil well      TD 3778

8" @ 221 Heeb. 3232 Br. lime 3367

Lans. 3378    DST 3390-3410    open 1 hr.

Rec. 45' ocm DST 3575-3608 open 45 min.

Rec. 30' mud    Cong. 3632    Simp. 3678

Sand 3697    Arb. 3728    DST 3729-33

open 1 hr. Rec. 420' oil TD 3778

5" @ 3777 18/ 3729-32 200 A 10 boph

Comp. 41 bopd

J. E. TYRA