

KANSAS

Company Natural Gas & Oil

WEST

EAST

SOUTH

Stafford

KANSAS

SEC.	TWP.	R.
28	21	13W

WELL NO.

#6 Morrison

FARM

COMPANY

Natural Gas & Oil

CONTRACTOR

Lewis Drlg.

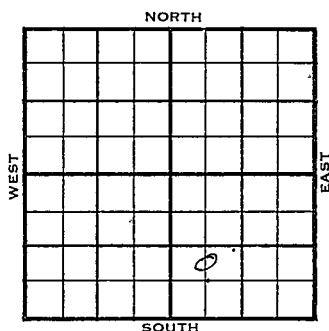
Gates

_____ Ft. from N. Line

_____ Ft. from S. Line

_____ Ft. from E. Line

_____ Ft. from W. Line

C N $\frac{1}{2}$ SW SE

	ELEVATION	REPORT
1956	1895'	
2-22	RUR	
3-21	Comm. 2-20-56 8 5/8" @ 283/225 DST 3666-87 op 1 hr. gas in 50 min, rec. 295' gassy oil, 880/15" DST 3690-3730 op 1 hr. rec. 15' mud, 0/15" 5 1/2" @ 3728- w/125 CO to 3704, 49/ 3660-68, 72/ 3674-86 B/ 10 bo, 250 A, SD 6 hrs. S/ 2.25 boph, 6 hrs., Comp. 52 bopd H. 3246 BL. 3376 L. 3387 C. 3665 S. 3717 TD 3730	
COMPLETED		

County Stafford Elev. _____
 Sec. 28 Twp. 13W Rge. 13W
 Company Natural Gas & Oil
 Farm Name Morrison No. 6

TOPS	DEPTH	LOG	DATUM
Anh.			
Tr.			
H.			
Tr.			
Dg.			
Bl.			
L.			
K.C.			
B.K.C.			
Ce.			
C.			
M.			
M.			
K.			
Mz.			
Mq.			
V.			
S.			
S.			
A.			
R.			
PE.			
G.			
T.D.			

Loc. in Sec. _____

C N $\frac{1}{2}$ SW SE

Geol. _____

Contr. _____

Lewis Drig.

Pool _____

Ga tes

FIRST REPORT

FEB 22 1958

Date Comm. _____

R U R

Co.

Lse.

No.

Sec.

T.

R.

County Stafford Elev. 1895
 Sec. 28 Twp. 24 Rge. 13W
 Company Natural Gas & Oil
 Farm Name Morrison No. 6

TOPS	DEPTH	LOG	DATUM	Loc. in Sec.
Anh.				C N $\frac{1}{2}$ SW SE
TP.				
H.	3246			
Tr.				
Dg.				
BL.	3376			
L.	3387		1492	Geol.
K.C.				Contr.
B.K.C.				
Ce.				
C.	3665		1770	Lewis Drlg.
M.				
M.				Pool
K.				Gates
Mz.				
Mq.				
V.				
S.	3717		1822	
S.				
A.				
R.				
PE.				
G.				
T.D.	3730			

Date Comm. 2-20-56 MAR 21 1956

8 5/8" @ 283/225 DST 3666-87

open 1 hr. gas in 50 min. rec. 295'

gassy oil 880/15" DST 3690-3730

open 1 hr. rec. 15' mud 0/15"

5 1/2" @ 3728/125 CO to 3704 49/ 3660-68

72/ 3674-86 B/ 10 bo 250 A SD 6 hr.

S/ 2.25 boph 6 hr. Comp. 52 bopd