

Stafford


KANSAS

SECTION 28 TOWNSHIP 21 RANGE 14 W

WELL NO. #2 Eva Smith

COMPANY Skelly Oil & Columbian Buel

NORTH

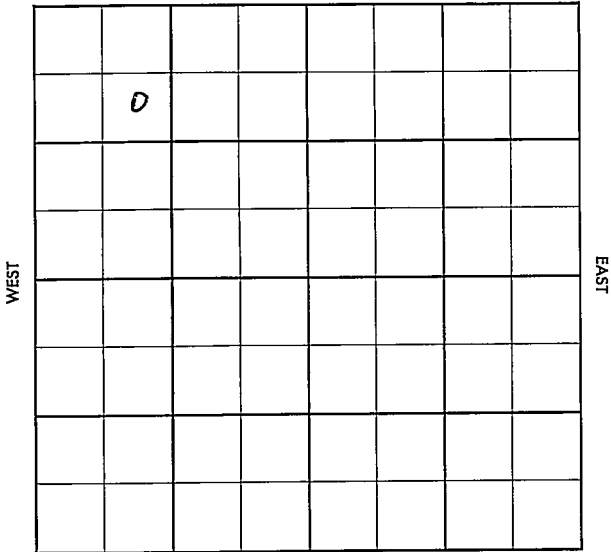

SOUTH

Stafford

KANSAS

SEC.

TWP.

R.

28

21

14W

WELL NO.

#2 Eva Smith

FARM

COMPANY

Skelly Oil & Columbian Fuel

CONTRACTOR

Wentworth

NW Lincoln


Ft. from N. Line

Ft. from S. Line

Ft. from E. Line

Ft. from W. Line

SE NW NW

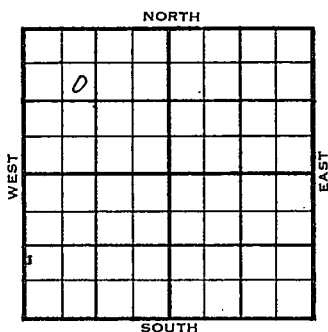SDX $\frac{1}{4}$ mile

1956

ELEVATION

REPORT

1942

1-11

Comm. 1-7-56

8" @ 870/450

WOC

Anh. 858'

1-19

Drlg. 3010

1-25

D & A

H.

3330

Tr.

3357

Dg.

3375

BL.

3454

L.

3464

3464

BKC

3712

3712

V.

3994

3994

S. Sh.

4007-

4007

A.

4015

4015

TD 4070'

ABANDONED

County Stafford Elev. _____
 Sec. 28 Twp. 21 Rge. 11W
 Company Shelly Oil & Columbian Fuel
 FarmName Eva Smith No. 2

Co.

Lse.

No.

Sec.

T.

R.

TOPS ☒ DEPTH LOG DATUM

Anb.	858		
Tr.			
H.			
Tr.			
Dg.			
BL.			
L.			
K.C.			
B.K.C.			
Ce.			
C.			
M.			
M.			
K.			
Mz.			
Mq.			
V.			
S.			
S.			
A.			
R.			
Pe.			
G.			
T.D.			

Loc. in Sec.

SE NW NW

Geol.

Contr.

Wentworth

Pool

NW Lincoln

0 1/4 mile	
JAN 11 '56	
FIRST REPORT	

Date Comm. 1-7-56

8" @ 870/450 WOC

County Stafford Elev. 1942
 Sec. 28 Twp. 12N Rge. 11W
 Company Skelly Oil & Columbian Fuel
 Farm Name Eva Smith No. 2

TOPS	DEPTH	LOG	DATUM	Loc. in Sec.
Anh.	8.58			SE NW NW
T.P.				
H.		3330		
Tr.		3357		
Dg.		3375		
BL.		3454		
L.	3464	3464	1522	Geol.
K.C.				Contr.
B.K.C.	3712	3712	1770	Wentworth
Ce.				
C.	3761	3761	1819	Pool
M.				NWLincn
M.				
K.				
Mz.				
Mq.				
V.	3994	3994	2052	
S. <i>sk</i>	4007	4007	2065	
S.				
A.	4015	4015	2073	
R.				
Pe.				ABANDONED
G.				
TD.	4070			

Date Comm. 1-7-56 JAN 25 1956
8" @ 870/450

D & A