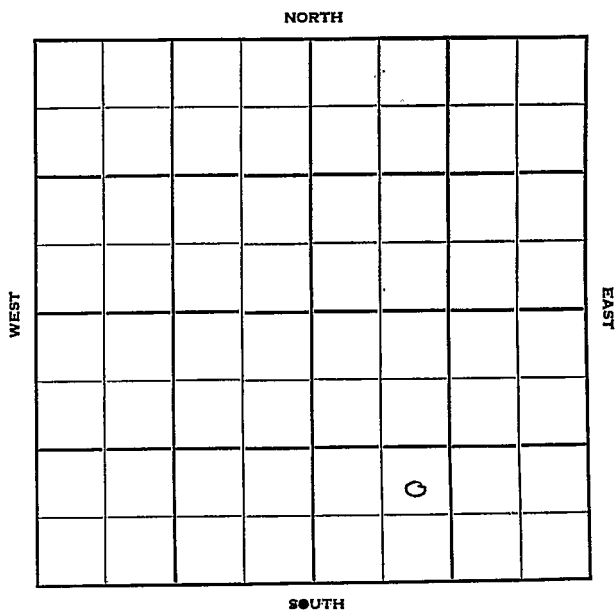


Section 28 Township 21 Range 14WWell No. #1 KeenanCompany Pickrell Drlg.

Sec. 28 Twp. 21 R. 14 W.

Well No. # 1 Keenan Farm

Pickrell Drlg. Company

Pickrell Contractor

Wildcat


 Ft. from N. Line

990 Ft. from S. Line

 Ft. from E. Line

990 Ft. from W. Line


NE SW SE

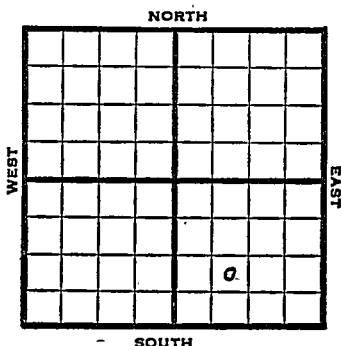

1952	Elev. 1942' REPORT
1/9	Spud 1-5-52 8" @ 270' Drlg. 1862'
1/16	Spud 1-5-52' D & A TD 3880' 8" @ 270 Heeb 3298' Br.lime 3419' Lans. 3430' Cong. 3732' Viola 3769' Simp. 3809' Arb. 3854' TD 3880' D & A ABANDONED



J. E. TYRA

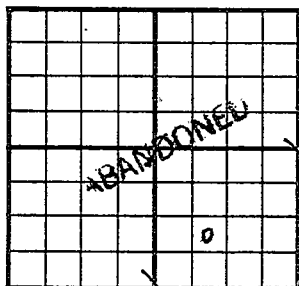County Stafford State KansasSec. 28 (Blk. Twp.) 21 (Sur. Rge.) 14W Map No.Operator Pickrell Drlg.Well No. 1 Farm KeenanElev. 1942 Location NE SW SE990 Ft. From S Line SE990 Ft. From W Line Quarter

1st. Report

Completion JAN 16 1952Remarks WildcatPickrell Drlg. - Contr.Spudding Date 1-5-52Drlg. Data D & A TD 38808" @ 270 Heeb. 3298 Br. lime 3419Lans. 3430 Cong. 3732 Viola 3769Simp. 3809 Arb. 3854 TD 3880D & A