


Section 28 Township 21 Range 14-W

Well No. #1 Strickler

Company Derby Oil et al

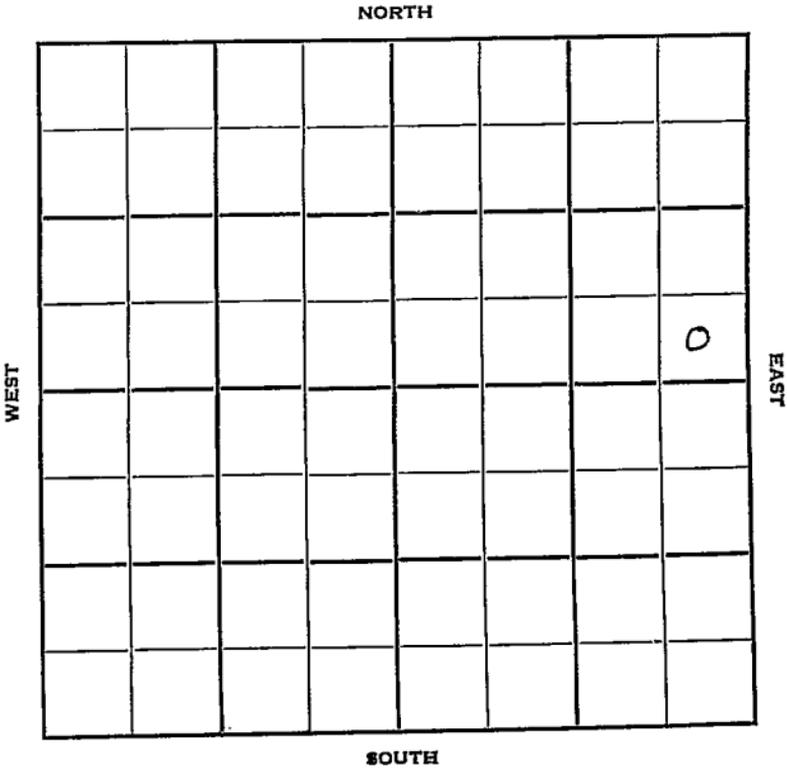

Sec. 28 Twp. 21 R. 11-W

Well No. #1 Strickler Farm

Derby Oil et al Company

Contractor


Wildcat

Ft. from N. Line

330 Ft. from S. Line

330 Ft. from E. Line

Ft. from W. Line

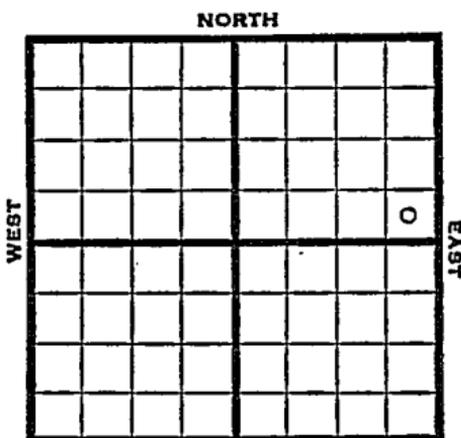

SE SE NE

Sinclair DHM Phillips famous

1950 Elev 1938 REPORT

8/2 MIM

8/23 Spud 8-2-50

8 5/8" @ 247

Heeb 3308

Br lime 3428

Lans 3437

Cong 3694

Viola 3740

Sigp 3812

Arb 3840

TD 3900

D&A

ABANDONED

Kansas

Map No. _____ Sec. 28 Twp. 21 R. 14W

Well No. 1 Strickler

Derby Oil etal. _____ Company

_____ Contractor

SE SE NE


_____ Ft. from N. Line

330 Ft. from S. Line

330 Ft. from E. Line

_____ Ft. from W. Line

SECTION PLAT

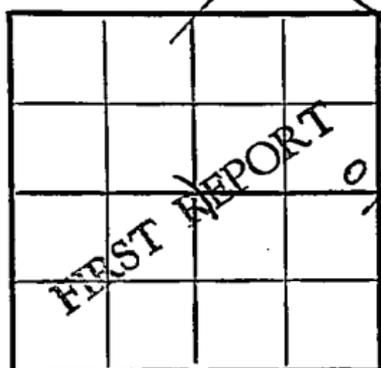

Stafford County

Location _____

Rig up _____

Drilling and Remarks:

M I M

Sinclair DHM

Phillips farmout

RECORD

Cased _____ in., _____ ft.

Sand _____

Gas _____

Oil _____

Total Depth _____

PRODUCTION

1st 24 hrs. Nat. _____

1st 24 hrs. after shot _____

Gas _____ Cu. Ft.

Dry Hole _____

Abandoned _____

Date

AUG 2 1950

19

J. E. TYRA Scout


County Stafford State Kansas

Sec. 28 (Blk. Twp.) 21 (Sur. Rge.) 14W Map No.

Operator Derby Oil et al.

Well No. 1 Farm Strickler

Elev. 1938 Location SE SE NE

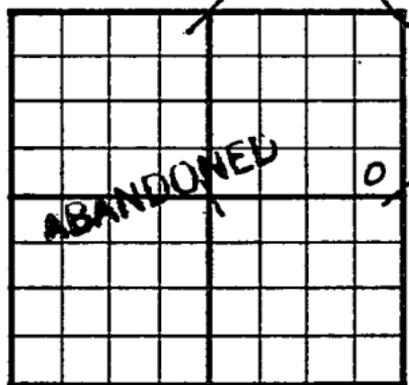

330 Ft. From S Line NE

330 Ft. From E Line Quarter

Ist. Report

Completion AUG 23 1950

Remarks

Wildcat

Spudding Date 8-2-50

Drlg. Data D & A TD 3900

8 5/8" @ 247 Heeb. 3308 Br. lime 3428

Lans. 3437 Cong. 3694 Viola 3740

Simp. 3812 Arb. 3840 TD 3900

D & A