

RICE

KANSAS


DX 78-1

Section 28 Township 21S Range 7W

Well No. #2 Ponce

Company C. M. Murtag, Jr., Tulsa

NORTH

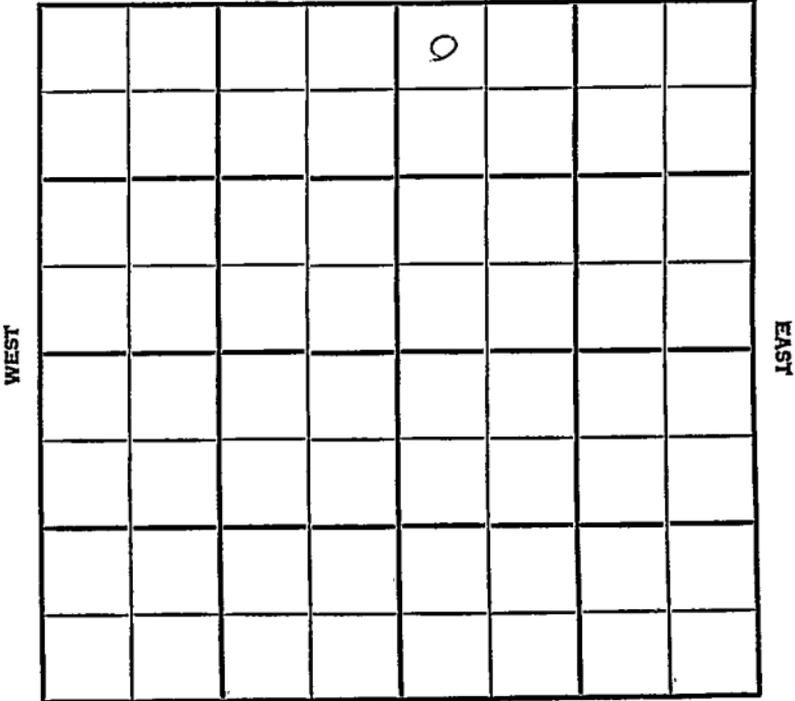

SOUTH

| | | |
|------------|-------------|----------|
| SEC. 28 | TWP. 21S | R. 7W |
|------------|-------------|----------|

WELL NO. 2 Ponce FARM

COMPANY C. M. Murray, Jr., Tulsa

CONTRACTOR Sterling rig #1


Ponce

_____ FT. FROM N. LINE

_____ FT. FROM S. LINE

_____ FT. FROM E. LINE

_____ FT. FROM W. LINE

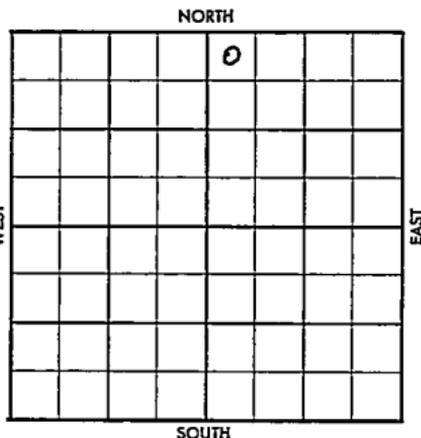

NW NW NE

| | | |
|----------|-----------|--------|
| | ELEVATION | REPORT |
| 19561609 | | |

6-20 MI


7-18 Comm. 6-18-56
 8 5/8" @ 150 w/100
 DST 3370-80 op 1 hr, rec. 90' HO&GCM,
 BHP 350#.
 DST 3388-95 ~~no~~ flow oil in 40 min.
 5 1/2" @ 3384 w/50
 CO 3395
 Flow 100 BO no/wtr., 8 hrs.
 P & F/ 20 BOPH, nowtr.
 Est. P/ 25 BOPD, no/wtr.
 H. 2711'; BL. 2896'; L. 2908';
 BKC 3286). C. 3370';
 TD 3395'

COMPLETED

County Ellice Elev. _____
 Sec. 28 Twp. 21S Rge. 7W
 Company C.M. Murray, Jr., Tulsa
 Farm Name Ponce No. 2

| TOPS | DEPTH | LOG | DATUM |
|--------|-------|-----|-------|
| Anh. | | | |
| Tp. | | | |
| H. | | | |
| Tr. | | | |
| Dg. | | | |
| Bl. | | | |
| L. | | | |
| K.C. | | | |
| B.K.C. | | | |
| Ce. | | | |
| C. | | | |
| M. | | | |
| M. | | | |
| K. | | | |
| Mz. | | | |
| Mo. | | | |
| V. | | | |
| S. | | | |
| S. | | | |
| A. | | | |
| R. | | | |
| PE. | | | |
| G. | | | |
| T.D. | | | |

Loc. in Sec. NW NW NE
 Geol. _____
 Contr. _____
Sterling
rig #1
 Pool
Ponce

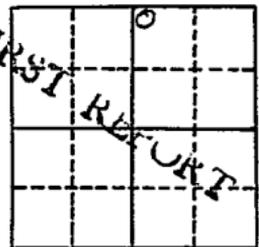

Date Comm. JUN 20 '56

MI

[Large handwritten scribble]

FORM 513 1955

Co.
 Sec.
 No.
 T.
 R.

County Rice Elev. 1609
 Sec. 28 Twp. 21S Rgt. 7W
 Company G.M. Murray, Jr., Tulsa
 Farm Name Ponce No. 2

| TOPS | DEPTH | LOG | DATUM | Loc. in Sec. |
|--------|-------|-----|-------|--------------|
| Ank | | | | NW NW NE |
| Tr. | | | | |
| H. | 2711 | | | |
| Dg. | | | | |
| Bl. | 2896 | | | |
| L. | 2908 | | | |
| K.C. | | | | Geol. |
| B.K.C. | 3286 | | | Contr. |
| Ce. | | | | Sterling |
| C. | 3370 | | | rig #1 |
| M. | | | | Pool |
| K. | | | | Ponce |
| Mz. | | | | |
| Mo. | | | | |
| V. | | | | |
| S. | | | | |
| S. | | | | |
| A. | | | | COMPLETE |
| R. | | | | |
| PE | | | | JUL 8 1956 |
| G. | | | | |
| TD | 3395 | | | |

Date Comm. MI JUN 27 '56 6-28-56 85/8 150
1100' @ 3309 JUL 3 '56 DST 3370-80
1hr run 90' HOE 6CM BHP
350 DST 3388-95 Flow oil
40" 572 3384/50 JUL 11 '56 CO
3395 Flow 100 Bo no/w 8
has ROP PE' Flw 20 Boph
no water. JUL 18 '56 est P. 25
Bopd no water