


Rice

KANSAS

SECTION 28 TOWNSHIP 21 RANGE 7W

WELL NO. #3 Ponce

COMPANY ~~Sterling Drlg.~~ C. M. Murray

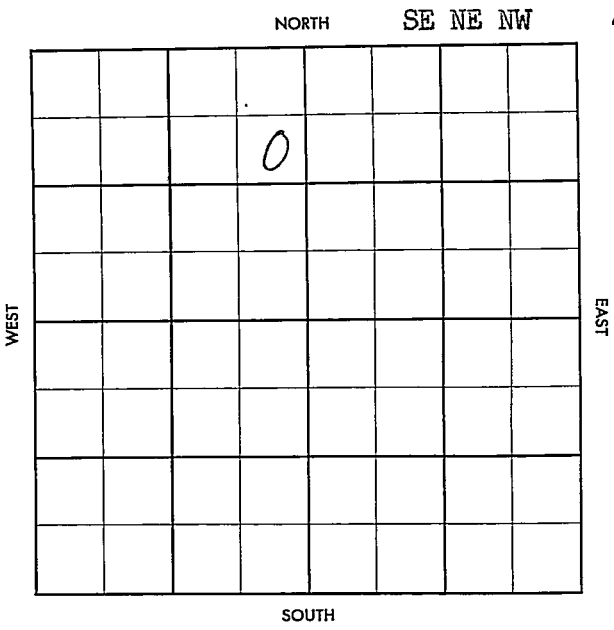

12

FORM 513 SUNRAY

County Rice Elev. _____
 Sec. 28 Twp. 21 Rge. 7W
 Company Sterling Drlg.
 Farm Name Ponce No. 3

Co.


| TOPS | DEPTH | LOG | DATUM |
|--------|-------|-----|-------|
| Anh. | | | |
| Tp. | | | |
| H. | | | |
| Tr. | | | |
| Dg. | | | |
| Bl. | | | |
| L. | | | |
| K.C. | | | |
| B.K.C. | | | |
| Ce. | | | |
| C. | | | |
| M. | | | |
| M. | | | |
| K. | | | |
| Mz. | | | |
| Mq. | | | |
| V. | | | |
| S. | | | |
| S. | | | |
| A | | | |
| R. | | | |
| PE. | | | |
| G. | | | |
| T.D. | | | |

Loc. in Sec. _____
SE NE NW

Geol. _____
 Contr. _____

Co. tools _____

Pool _____
Ponce

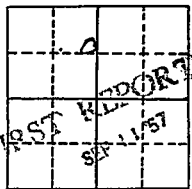

Lse.

No.

Date Comm. _____
 Location _____

Sec.

T.

R.

SECTION

County Rice Elev. _____
 Sec. 28 Twp. 21 Rge. 7W
 Company Sterling Drig. C M MURPHY
 Farm Name Ponce No. 3

Co.
Lse.
No.
Sec.
T.
R.

| TOPS | DEPTH | LOG | DATUM |
|-------------------|-------|-----|-------|
| Anb. | | | |
| TP. | | | |
| H. | 2713 | | |
| Tr. | | | |
| Dg. | | | |
| Bl. | | | |
| L. | 2903 | | |
| K.C. | | | |
| B.K.C. | | | |
| Ce. | | | |
| C. <u>Sh</u> | 3370 | | |
| <u>M. C. L. C</u> | 3376 | | |
| M. | | | |
| K. | | | |
| Mz. | | | |
| Me. | | | |
| V. | | | |
| S. | | | |
| S. | | | |
| A. | | | |
| R. | | | |
| PE. | | | |
| G. | | | |
| T.D. | 3425 | | |

Loc. in Sec. SE NE NW
 Geol. _____
 Contr. Co. tools
 Pool Ponce
 0
 NOV 13 57
COMPLETE

Date Comm. _____
 Location SEP 18 57 SEP 27 9-16-57
8 200/135 @ 3325 11 2 57
PST 3391-95 1 1/2 160' @ 160'
MCD 90' H 16 CM BHP 875
5" 3378 OCT 9 57 CD 3425 PB
3400 fld 130' 1" fshg
OCT 5 57 150A Frac fld
OCT 13 57 OCT 20 57 13 57 FU 2700' Oil NW
NT POP 11 57 2580 pd NW