


DX 78-1

Rice KANSAS

Section 28 Township 21 Range 7W

Well No. 1 Stucky

Company J. E. Day

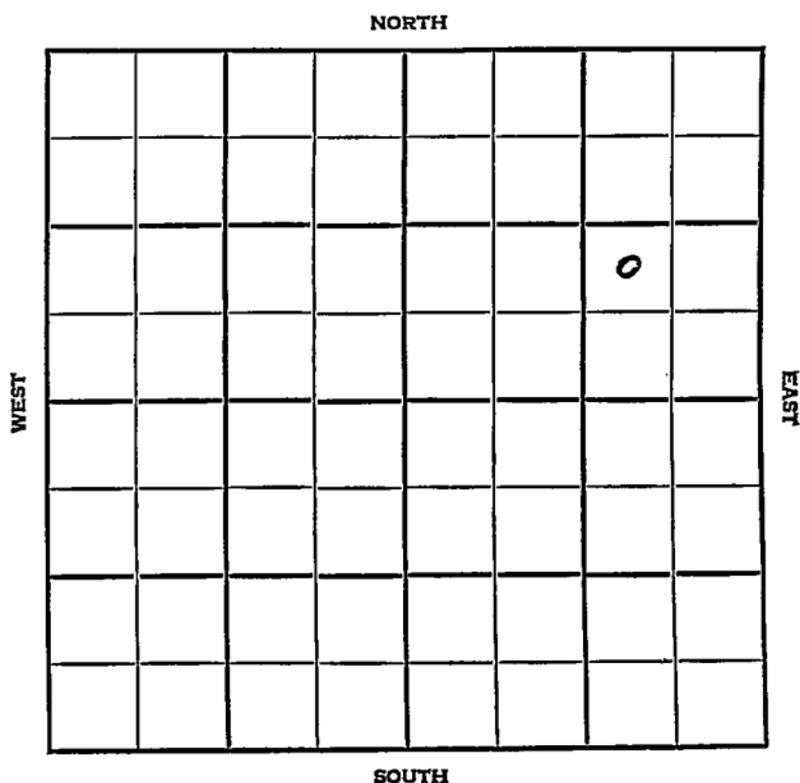

Rice

KANSAS

SEC.	TWP.	R.
28	21	7 W

WELL NO. # 1 Stucky FARM

COMPANY J. E. Day

CONTRACTOR Rex & Morris
Ponca Pool


_____ Ft. from N. Line

990 _____ Ft. from S. Line

990 _____ Ft. from E. Line

_____ Ft. from W. Line

NW SE NE

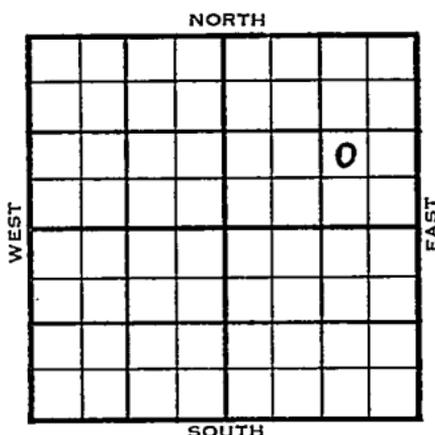

1955 ELEVATION REPORT

4/20 Location


County Rice State Kansas

Sec. 28 (Blk. 21 (Sur. Rge.) 7W Map No.

Operator J. E. Day

Well No. 1 Farm Stucky

Elev. _____ Location NW SE NE

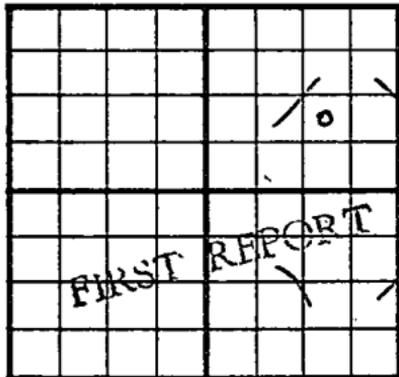

990 Ft. From S Line NE

990 Ft. From E Line Quarter

1st. Report APR 20 1955

Completion _____

Remarks _____

Rex & Morris - Contr.

Spudding Date _____

Drlg. Data Ponca Pool

Location

FABEN GILSTRAP