


Rice

KANSAS

SECTION 28 TOWNSHIP 21S RANGE 7W

WELL NO. #1 F.E. Arbuckle

COMPANY F. Raymond

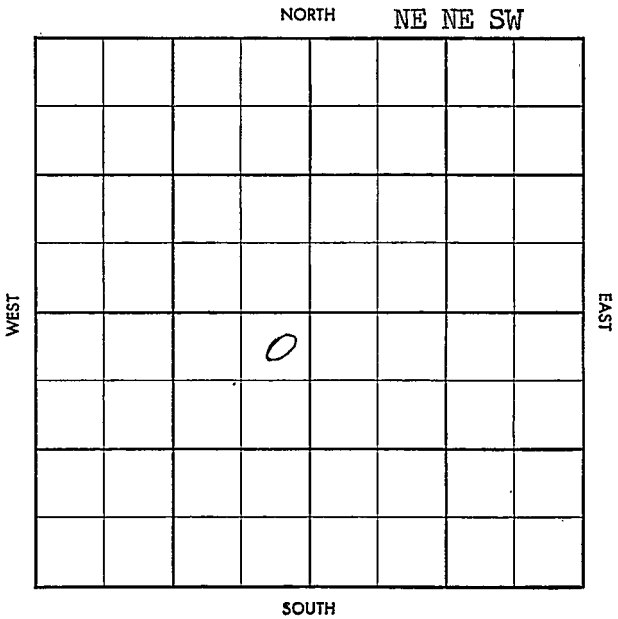

CO. Rice ELEV. 1613 RB
SEC. 28 TWP. 21 RGE. 7W
COMPANY F. Raymond NO. 1

CO. _____
SEC. _____
TWP. _____
RGE. _____
OCT 16 '57

FARM F. E. Arbuckle
LOC. NE NE SW

462719
D9542742
B1-2896
L 2916
Bkc 3281
SAC 3370
C 3381
Mch 3394
TD 3443

GEOL. _____
CONTR. Co. tools
POOL Ponce
SPUD 10-5-57
8" @ 221/100
drlg. 2325
DST 3384-3408
1 1/2 hrs 95' M BHP
355 DST 3408-27
1 1/2 hrs 40' M RP

15-25 BHP 85

no log

D & A

CO. _____
SEC. _____
TWP. _____
RGE. _____