


Rice

Map No. KANSAS Sec. 28 Twp. 71 R. 7W

Well No. 1 Foster Ponce Farm
Ray et al Company

330 Ft. from N. Line
____ Ft. from S. Line
990 Ft. from E. Line
____ Ft. from W. Line

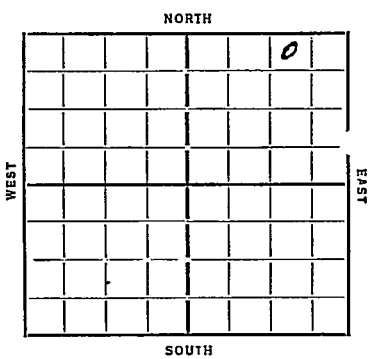

| Date | REPORT |
|-------|---------------------------------|
| 1935 | |
| 1/30 | Ponds |
| 2/7 | — |
| 2/14 | Material |
| 2/21 | — |
| 2/28 | Bldg. |
| 3/7 | Rig |
| 3/14 | — 3/21 — 3/28 — |
| 4/4 | Blg 575 |
| 4/11 | — |
| 4/18 | Blg 1700 |
| 4/26 | " 2000 |
| 5/2 | " 2400 |
| 5/9 | — |
| 5/16 | Blg 2400 |
| 5/23 | — 5/29 — 6/6 — 6/13 — 6/20 — |
| 6/28 | — 7/5 — 7/11 — 7/18 — |
| 8/8 | — 8/15 — 8/22 — 8/29 — |
| 9/6 | SD 2460 |
| 10/3 | — 10/10 — 11/1 — 11/7 — 11/14 — |
| 11/2 | Blg 2975 |
| 11/29 | SD 2391 6" 3000 |
| | Blg 3012 (OVER) |

12/6 6" 3125 WR 3140

12/13 TD 3203 S.D.

12/19 TD 3350
WR 6" 3340

12/26 —

1/2/36 6" 3340 Oly plugs

1/10 Top Chat 3388
TD 3400
700' Oil 5 hrs S.D.

1/17 Bldg tanks

1/24 —

1/31 flowed 90 Oil 45 Min
Swabbed 110 Oil 3 hrs
SD Cold weather

2/7 —

2/14 Swabbed 116 Bbls 4 hrs
12 Bbls P/H next 2 hrs
300' off stem

2/21 —

2/28 flowed 91 Bbls in 50 Min
shut in

3/6 — 3/13 —

Map No. _____ Sec. _____ Twp. _____ R. _____

Well No. _____ Farm _____


_____ Company _____

_____ Ft. from N. Line

_____ Ft. from S. Line

_____ Ft. from E. Line

_____ Ft. from W. Line

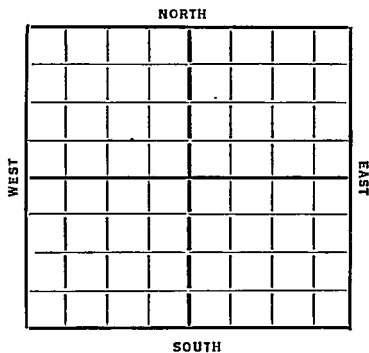

Date

REPORT

3/20 Rigging 6" Liner.
 3/27 —
 4/2 S.D.
 4/10 — 4/16 — 4/23 —
 4/30 1700 ACID - NO TEST —
 5/7 600 ACID - PUMP 133 bbls IN
 5 HOURS. CLEANING OUT.
 5/14 SHUT DOWN.
 5/21 — 5/28 — 6/4 —
 6/11 T.D. 3431' 20 bbls OIL PER. DAY.
 6/18 — 6/25 —
 6/25 SHUT DOWN.
 7/2 — 7/9 —

7/15/36 - Chat 3388'
 T.D. 3431'
 600 Gallons of acid
 20 bbls of oil.

COMPLETED

Map No. 49 Sec. 28 Twp. 21 R. 7W

Well No. 1- Fossey

Hay et al Company

Contractor

FIRST REPORTS

SECTION PLAT

330 Ft. from N. Line

..... Ft. from S. Line

990 Ft. from E. Line

..... Ft. from W. Line

| | | | |
|--|--|--|---|
| | | | 0 |
| | | | |
| | | | |
| | | | |
| | | | |

Location.....

Rig up.....

Drilling and Remarks:

ponds

RECORD

Cased.....in.,ft.

Sand.....

Gas.....

Oil.....

Total Depth.....

PRODUCTION

1st 24 hrs. Nat.....

1st 24 hrs. after shot.....

Gas.....Cu. Ft.

Dry Hole.....

Abandoned.....

Date

1-30-35 192.....

ORVAL MANNSCHRECK
Scout

Map No. 49 Sec. 28 Twp. 21 R. 7W

Well No. 1 - Ponce

Ray et al Company
Contractor

N.W N.E N.E

SECTION PLAT

330 Ft. from N. Line

..... Ft. from S. Line

990 Ft. from E. Line

..... Ft. from W. Line

| | | | |
|--|--|--|---|
| | | | 0 |
| | | | |
| | | | |
| | | | |
| | | | |

CORRECTION

Location.....

Rig up.....

Drilling and Remarks:

*has been carried
as #1, Fossey*

RECORD

Cased..... in., ft.

Sand.....

Gas.....

Oil.....

Total Depth.....

PRODUCTION

1st 24 hrs. Nat.....

1st 24 hrs. after shot.....

Gas..... Cu. Ft.

Dry Hole.....

Abandoned.....

Date

JAN 8 1936

ORVAL MANNSCHRECK

192..... Scout

Map No. 49 Sec. 28 Twp. 21 R. 2W

Well No. 1 Ponce

Hay et al Company
Contractor

SECTION PLAT

| | | | |
|--|--|--|---|
| | | | 0 |
| | | | |
| | | | |
| | | | |

330 Ft. from N. Line

_____ Ft. from S. Line

990 Ft. from E. Line

_____ Ft. from W. Line

COMPLETED

Location _____

Rig up _____

Drilling and Remarks:

Chd 83388
600 acid
20 1/2 lb

RECORD

Cased _____ in., _____ ft.

Sand _____

Gas _____

Oil _____

Total Depth 3431

PRODUCTION

1st 24 hrs. Nat. _____

1st 24 hrs. after shot _____

Gas _____ Ch. Ft.

Dry Hole _____

Abandoned _____

Date

JUL 15 1936 19

S. J. LEWIS Scout