


Section 28 Township 21 Range 10WWell No. #1 PriceCompany Black Cat Oil

NORTH

WEST

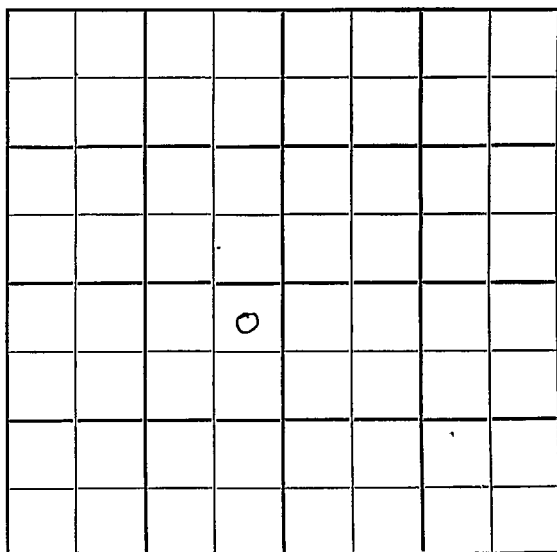

EAST

SOUTH

Rice

Sec. 28 Twp. 21 R. 10W

Well No. #1 Price Farm

Black Cat Oil Company

Contractor

Wildcat


330' Ft. from N. Line

_____ Ft. from S. Line

330' Ft. from E. Line

_____ Ft. from W. Line

NE NE SW

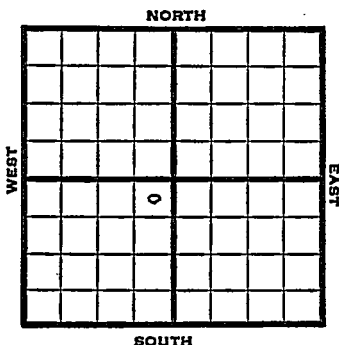

1951 Elev. 1750' REPORT

5/2 Drlg.

5/23 D&A TD 3525
Lans. 3065
DST 3127-3180 opn 1 hr
Rec. 80' mud
Cong. 3412 Arb. 3500-25 TD
D&A **ABANDONED**

J. E. TYRA

