


Section 28 Township 21 Range 11 W

Well No. # 1 Chesky

Company Amerada Pet.

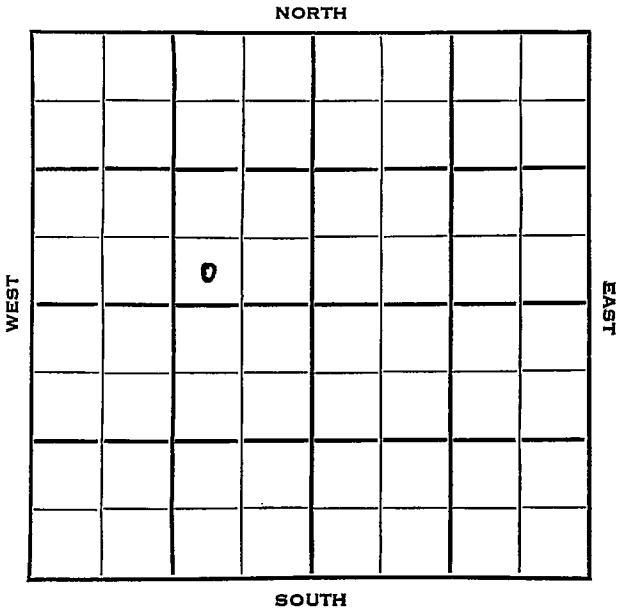

Sec. 28 Twp. 21 R. 11W

Well No. #1 Chesky Farm \_\_\_\_\_

Amerada Pet. Company \_\_\_\_\_

Wildcat. Contractor \_\_\_\_\_


\_\_\_\_\_ Ft. from N. Line

330 Ft. from S. Line

990 Ft. from E. Line

\_\_\_\_\_ Ft. from W. Line

SW SE NW

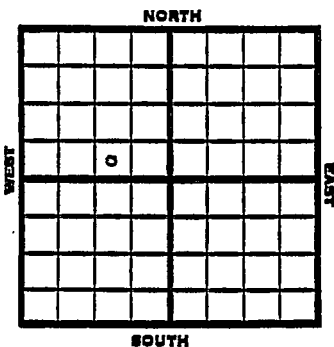

1953 Elev. 1739' REPORT

8/5 Location

8/12 8" @ 240 w/200  
Drlg. 1815'

8/19 Heeb 2953, Tor 2973  
DST 2974-89, 1 hr., 30' m, 620#  
Br li 3086, Lans 3107  
DST 3137-55, 1 hr., 40' M + SSO  
DST 3193-3200, 2 hrs., 11' mcw, 1190#  
DST 3263-72, 1 hrs., 25' M, 440#  
Cong 3372  
Drlg. 3379'

8/26 Spud 8-7-53  
D&A  
TD 3518  
8" @ 240  
Heeb 2953, Tor 2973,  
DST 2974-89, opn 1 hr., rec. 30' mud  
620#  
Br lime 3086, Lans 3107  
DST 3137-55, opn 1 hr., rec. 40' mud,  
0#  
DST 3193-3200, opn 2 hrs., rec. 11'  
mcw, 1190#  
DST 3263-72, opn 1 hr., rec. 25' mud  
440#  
Cong 3372  
TD 3518 - D&A

ABANDONED



