

KANSAS PawneeSection 28 Township 21 Range 16WWell No. 1 BrownCompany SunrayWildcat

NORTH

WEST								EAST

SOUTH

Sec. 28 Twp. 21 R. 16W

Well No. #1 Brown Farm

Sunray

Wildcat Pool (Steckle, Cont.) Company


330' Ft. from N. Line

 Ft. from S. Line

330' Ft. from E. Line

 Ft. from W. Line

NE SW

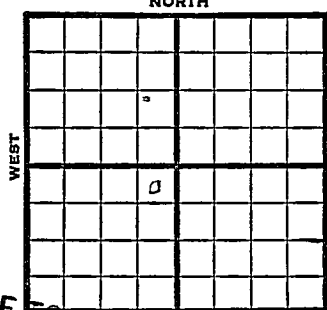

CLOSE TO OUR ACRESAGE

1949 Elev 2025' REPORT

5/25 Anhy. 1007'
8" @ 1010'

6/1 Lansing 3520'
Drlg 3579'

6/7 BKC 3729' Congl 3835'
Simpson 3846' Arbuckle 3851'
DST 3855-67 opn 10 minutes
4 M G
Core 3867-72
Rec 3' Crys Dolo Porosity SSO & Gas
Core 3872-78 Rec. 4' Crys Dolo SO
DST 3873-78 opn 1/2 hrs 2 1/2 Gas 100'
oil
Gravity 46.6°
DST 3876 1/2 - 81 1/2 TD
Open 1/2 hr. 2 1/2 M Gas 120' oil - 60' wtr
30' oil & gas cut mud
5" @ 3881'

3 4 5-1
3 5 2 0
3 3 1

3 4 5-1
3 5 2 0
1 2 6

6/15 " "
6/21 Drill cement to 3878 1/2
4 shots 3877 1/2 - 78 1/2
Flow 45 bbls oil PH 4 1/2 M Gas Oil
38° Grav.
6/28 Flow 40 bbls oil 4 1/2 M Gas.

7/6 Flow 80 bbls oil - 2,444,000
Gas through 24/64" choke 21 hrs.

7/12 " "
7/20 " "
7/27 " "

OVER

1949

8/3

TD 3881 $\frac{1}{2}$

Arb. 3856'

5"@ 3881'

Perf

Flow 80 Oil Pot

38° Gr.

Gas reported would not burn

Comp
COMPLETED

Map No. _____ Sec. 28 Twp. 21 R. 16W

Well No. 1 Brown

Sunray Company

Steckle Contractor

NE SW


FIRST REPORT
SECTION PLAT

330 Ft. from N. Line

_____ Ft. from S. Line

330 Ft. from E. Line

_____ Ft. from W. Line

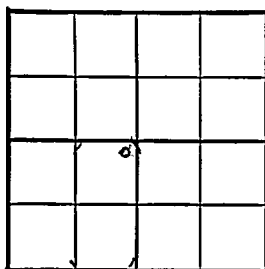

Pawnee County

Location _____

Rig up _____

Drilling and Remarks:

Anhy 1007

8" @ 1010

RECORD

Cased _____ in., _____ ft.

Sand _____

Gas _____

Oil _____

Total Depth _____

PRODUCTION

1st 24 hrs. Nat. _____

1st 24 hrs. after shot _____

Gas _____ Cu. Ft.

Dry Hole _____

Abandoned _____

Date

MAY 25 1949 19 S. J. LEWIS Scout

Kansas

Wildcat

Map No. K 81 Sec. 28 Twp. 21 R. 16WWell No. 1 Brown


Sunray

Company

COMPLETE

Contractor

NE SW

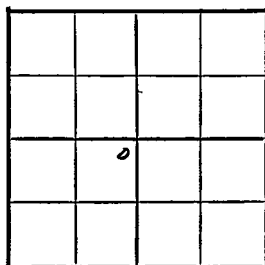F12025
SECTION PLAT330 Ft. from N. Line Ft. from S. Line330 Ft. from E. Line Ft. from W. Line

Pawnee County

Location

Rig up

Drilling and Remarks:


Date

RECORD

Cased in., ft.Sand Gas Oil Total Depth 388 1/2

PRODUCTION

1st 24 hrs. Nat. 1st 24 hrs. after shot Gas Cu. Ft.Dry Hole Abandoned

AUG 3

1949

19

S. J. LEWIS

Scout