


Section 28 Township 21 Range 16W

Well No. #1 Brown

Company Alpine Oil & Royalty

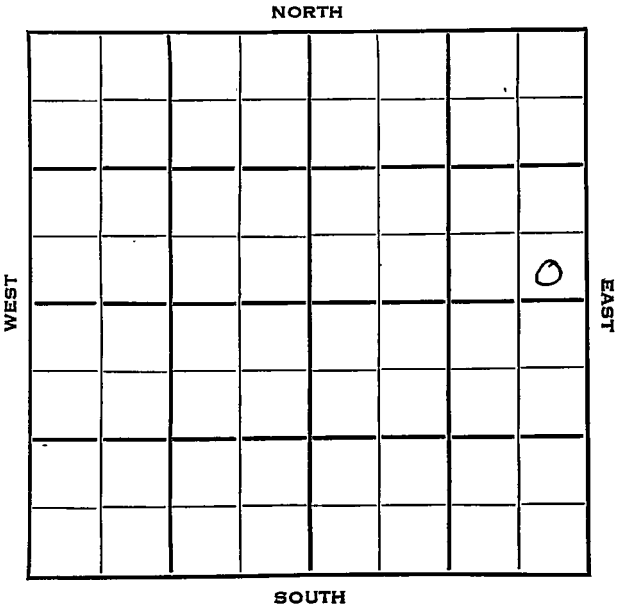

HOT FILE Pawnee KANSAS
 SEC. 28 TWP. R. 16 W ✓

WELL NO.

1 Brown

FARM

COMPANY

Alpine Oil & Royalty

CONTRACTOR


Alpine Oil & Royalty

_____ Ft. from N. Line

330 _____ Ft. from S. Line

330 _____ Ft. from E. Line

_____ Ft. from W. Line

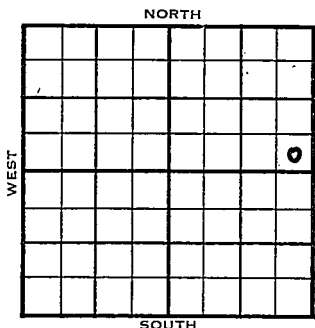

SE SE NE


MCPC has ^{N/2}SE 1/4 of ~~27~~ 21S-16W

	ELEVATION	REPORT
1953	1990'	
12/9	Location	
12/16	"	
12/22	Spudded 12-16-53	
	Anhy 980' 8" @ 990	
	Drlg. 1903'	(Ltr-McGehee)
12/31	Heeb 3432' Br lime 3531'	
	Lans. 3542'	
	Drlg. 3685'	(Ltr-McGehee)
1954		
1/7	D & A this week.	" "
1954		
1/6	Spud 12-16-53	
	D & A	
	TD 3920'	
	Anhy 980',	
	8" @ 990'	
	Heeb 3432', Br. Lime 3531', Lans 3542'	
	B KC 3795' Cong 3830'	
	TD 3920'	
	D & A	

ABANDONED

J. G. McGEHEE

County Pawnee State Kansas
 Sec. 28 (Blk.) 21 (Sur.) 16W Map No.
 Operator Alpine Oil & Royalty
 Well No. 1 Farm Brown
 Elev. 1990 Location SE SE NE

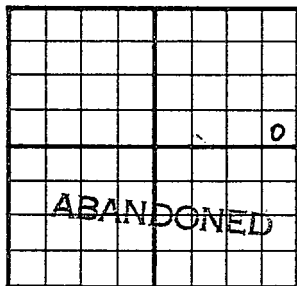

330 Ft. From S Line NE
330 Ft. From E Line Quarter

1st. Report

Completion JAN 6 1954

Remarks

Alpine Oil & Royalty-Cont

Spudding Date 12-16-53

Drlg. Data D & A TD 3920

Anhy 980 8" @ 990 Heeb. 3432

Br. lime 3531 Lans. 3542 B KC 3795

Cong. 3830 TD 3920

D & A

J. G. McGEHEE