


Section 28 Township 21 Range 16 W

Well No. # 1 Wedel

Company Sunray Oil Corp

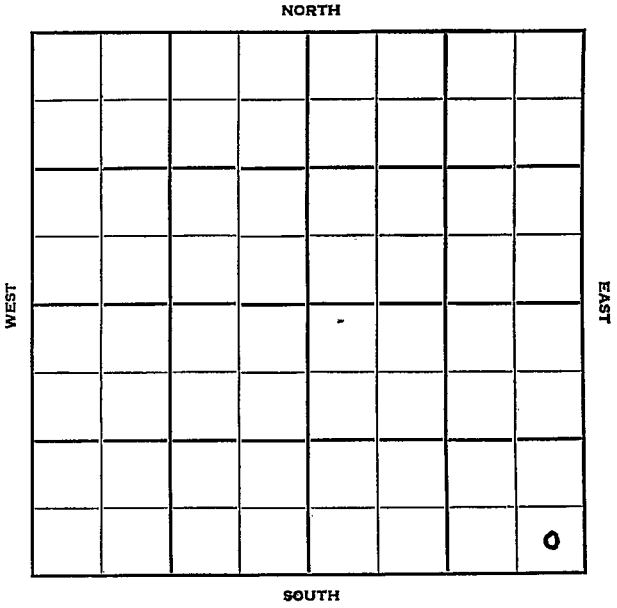

HOT FILE

Pawnee

KANSAS

Sec. 28 Twp. 21 R. 16 W

Well No. # 1 Wedel Farm

Sunray Oil Corp. Company

Stickle Drlg. Contractor
Larned Pool


_____ Ft. from N. Line

330 Ft. from S. Line

280 Ft. from E. Line

_____ Ft. from W. Line

SE SE SE

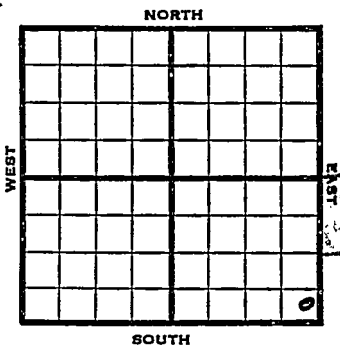

1953

Elev. 1997'

REPORT

6/24

Cellar & Pits

7/1

Anhy 985'

8" @ 993' w/600 sks

Drlg 1865'

7/8

Heeb 3411, Lans 3521

Drlg. 3777'

7/15

Spud 6-27-53

D&A

TD 4003

Anhy 985'

8" @ 993

Heeb 3411, Tor 3430, Br line 3514,

Lans 3524, Marm 3785, Cong 3824

TD 4003'

D&A

Handwritten calculations:

$$\begin{array}{r} 2006 \\ - 1997 \\ \hline 9 \end{array}$$

$$\begin{array}{r} 3824 \\ - 1997 \\ \hline 1827 \end{array}$$

ABANDONED

Handwritten calculations:

$$\begin{array}{r} 3824 \\ - 3524 \\ \hline 300 \end{array}$$

