

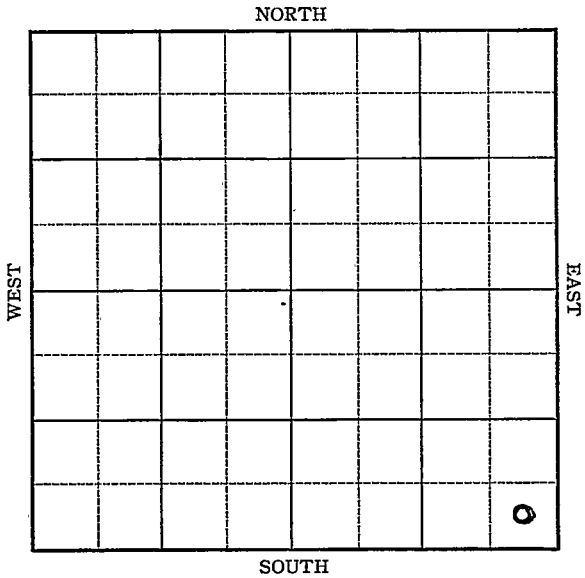
KANSAS

Form 51-5M 5-37 Petrol Stafford

Section 29 Township 21 Range 12-W

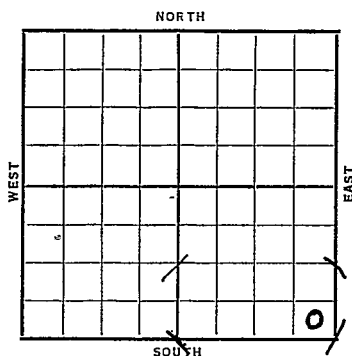
Well No. 1 Mueller

Company Torrey & Feaster et al



KANSAS -

Stafford

Sec. 29 Twp. 21 R. 12-WWell No. #1 Mueller FarmTorrey & Feaster et al Company Ft. from N. Line330 Ft. from S. Line330 Ft. from E. Line Ft. from W. Line

Date

REPORT

1938

1/26

R U R

2/4

12" - 248' Anhy 660' Drlg. 685'

2/11

Drlg. 2518'.

2/18

K.C. 3245'. S.O. 3349-50'.

Drlg. 3445'.

2/26

Base K. C. 3485'.

Viola 3512'.

Simp. shale 3526'.

Arb. 3594-3602' sat. core.

5" @ 3594'. RUST.

3/4

" " "

3/11

" " "

3/18

" " "

3/25

T.D. 3607'. 2200' oil.

2000 acid.

4/1

On potential.

OVER

1938

4/6

5" @ 3594'.

Arb. 3594'.

T.D. 3607'.

2000 acid.

Potential 1210 bbls.

Gravity 38.1

COMPLETED

Map No. _____ Sec. 29 Twp. 21 R. 12WWell No. 1 MuellerTorrey & Feaster et al Company

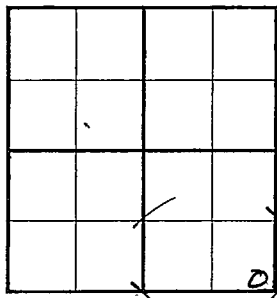
Contractor

FIRST REPORT**SE/C**

_____ Ft. from N. Line

330 Ft. from S. Line330 Ft. from E. Line

_____ Ft. from W. Line

SECTION PLAT

Location _____

Rig up _____

Drilling and Remarks:

RUR**RECORD**

Cased _____ in., _____ ft.

Sand _____

Gas _____

Oil _____

Total Depth _____

PRODUCTION

1st 24 hrs. Nat. _____

1st 24 hrs. after shot _____

Gas _____ Cu. Ft.

Dry Hole _____

Abandoned _____

Date

JAN 26 1938

19

H. D. Hatfield

Scout

Free

Returned	
Cards	<i>Paul</i>
Tracing	<i>JP</i>
France Map	
Scarborough Map	<i>Free</i>
Moody Map	
Scarborough Flat Book	
Moody Flat Book	

Stafford KANSAS

Map No. 46 Sec. 29 Twp. 21 R. 12WWell No. 1 MuellerTorrey & Feaster etal Company

Contractor

COMPLETED

SE/C

 Ft. from N. Line330 Ft. from S. Line330 Ft. from E. Line Ft. from W. Line

SECTION PLAT

			0

Location Rig up

Drilling and Remarks:

Good and
POT 1210
grav. 38.1

RECORD

Cased 5 in., 3594 ft.Sand Arb 3594Gas Oil Total Depth 3607

PRODUCTION

1st 24 hrs. Nat. 1st 24 hrs. after shot Gas Cu. Ft.Dry Hole Abandoned Date 1938

APR 6 - 1938 19

H. D. Hatfield

Scout

Ray

Ray

Returned	<i>Paul</i>
Cards	<i>Paul</i>
Tracing	<i>Joe</i>
France Map	<i>Ray</i>
Sanborn Map	<i>Ray</i>
Moody Map	<i>Ray</i>
Scarborough Plat Book	
Moody Plat Book	