


KANSAS

Section 29 Township 21 Range 12W

Well No. #2, Mueller

Company Isern Bros.

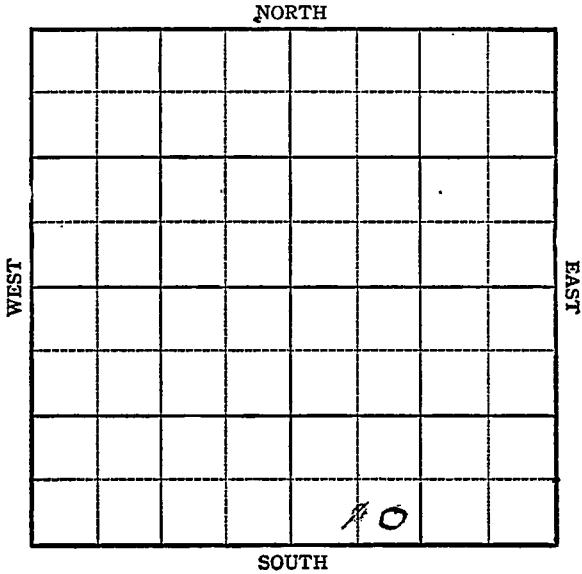

Sec. 29 Twp. 21 R. 12W

Well No. #2, Mueller Farm
Isern Bros. Company

Fischer


NORTH

_____ Ft. from N. Line

330 Ft. from S. Line

_____ Ft. from E. Line

990
660 Ft. from W. Line

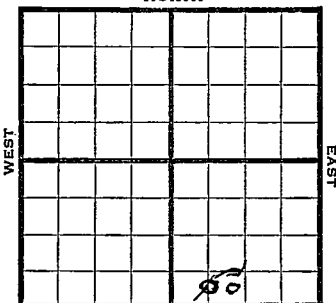

Elev. 1863

1944

REPORT

5/31 8" at 315'
Drlg. 1885'

6/7 Lans 3274
Viola 3495
Simp. 3531
Arb. 3581-89 TD
5" @ 3584
RUST

6/15 TD 3591-3200' oil in 10 hrs.

6/21 3400' oil 500 acid

6/28 5" ~ 3584
Arb. 3581
TD 3591
500 acid
Echo Pot. 2260
39.0 Gravity

COMPLETED

Pool Name Fischer

KANSAS
 Map No. 7 Sec. 29 Twp. 21 R. 12W

Well No. 2 Mueller

Isern Bros. _____ Company

FIRST REPORT _____ Contractor

C S L SW SE

SECTION PLAT

_____ Ft. from N. Line

330 Ft. from S. Line

_____ Ft. from E. Line

660 Ft. from W. Line

Stafford County

Location _____

Rig up _____

Drilling and Remarks:

8" - 315

1885

RECORD

Cased _____ in., _____ ft.

Sand _____

Gas _____

Oil _____

Total Depth _____

PRODUCTION

1st 24 hrs. Nat. _____

1st 24 hrs. after shot _____

Gas _____ Cu. Ft.

Dry Hole _____

Abandoned _____

Date

MAY 3 1 1944 19 _____

S. J. LEWIS Scout

Pool Name FischerMap No. KANSAS 29 Sec. 29 Twp. 21 R. 12WWell No. 2 MuellerIsern Bros. Company**COMPLETED**

Contractor

SE SW SE

SECTION PLAT

_____ Ft. from N. Line

330 Ft. from S. Line

_____ Ft. from E. Line

990 Ft. from W. Line

Stafford County

Location _____

Rig up _____

Drilling and Remarks:

Cr 35815" @ 3584500 acidEcho Pt 226039 3/4

RECORD

Cased _____ in., _____ ft.

Sand _____

Gas _____

Oil _____

Total Depth 3591

PRODUCTION

1st 24 hrs. Nat. _____

1st 24 hrs. after shot. 1

Gas _____ Cu. Ft.

Dry Hole _____

Abandoned _____

Date

JUN 28 1944 19S. J. LEWIS Scout