KANSAS


FORM 51 5M 6-46 PETROL

Stafford county

Section 29 Township 21 Range 12-W

Well No. #6, Fischer "A"

Company Republic Natural Gas

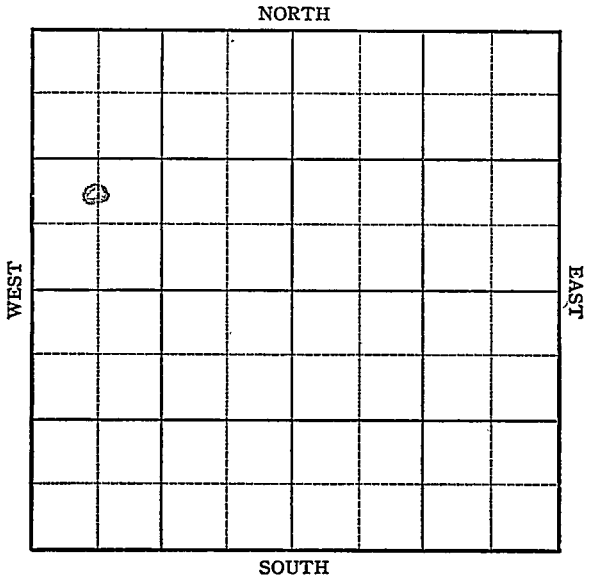

FORM 252-A
5M 6-46 PETROL

KANSAS


Stafford county

Sec. 29 Twp. 21 R. 12-W

Well No. #6, Fischer "A" Farm

Repbulic Natural Gas Company Company

Sittner Pool

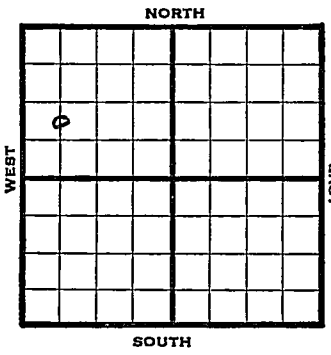

_____ Ft. from N. Line

990' Ft. from S. Line

_____ Ft. from E. Line

660' Ft. from W. Line

C N L SW NW

REPORT

1946	Elev. 1870'
10/30	Location.
11/6	"
11/12	10" @ 314 Anhy 385' Drlg 1810'
11/20	Drlg 3340'
11/27	Lans 3263' Arb 3604' TD 3610' 7" @ 3604', RUST
12/3	500 acid Swb 4 oil PH 6 hrs
12/10	" "
12/17	" "
1947	
1/4	500 acid, swb 4 oil PH 6 hrs
1/8	Pump 30 oil in 14 hrs.
1/15	" " "
1/21	" " "
1/30	" " "
2/5	" " "

OVER

2/12 Pump 30 oil in 14 hrs

2/19 Arb 3604'
7" @ 3604
500 Acid
Pump 84 Pot
40 Grav.
TD 3610'

COMPLETED

Form 26 200 Bks. 10-46 Petrol Kansas

Sittner Pool

Map No. 46 Sec. 29 Twp. 21 R. 12W

Well No. 6 Fischer "A"

Republic Natural Gas Company

FIRST REPORT

Contractor

C N L SW NW

Ft. from N. Line


990 Ft. from S. Line

Ft. from E. Line

660 Ft. from W. Line

Stafford County

SECTION PLAT

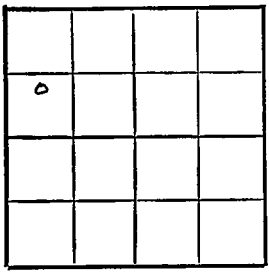

Location x

Rig up

Drilling and Remarks:

RECORD

Cased in., ft.

Sand

Gas

Oil

Total Depth

PRODUCTION

1st 24 hrs. Nat.

1st 24 hrs. after shot

Gas Cu. Ft.


Dry Hole

Abandoned

Date

OCT 3 0 1946 19

S. J. LEWIS Scout

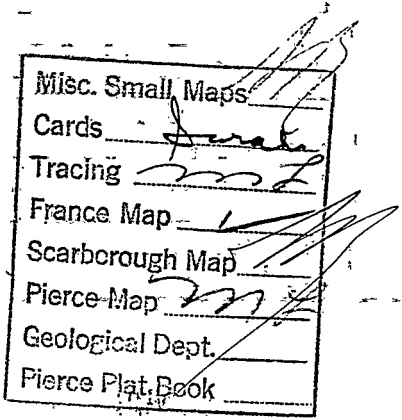
Misc. Small Maps
Cards
Tracing
France Map
Scarborough Map
Pierce Map
Geological Dept.
Pierce Plat Book

Form 26 200 Bks. 10-46 Petrol Kansas KANSAS

Sittner Pool

Map No. 4 1 n Sec. 29 Twp. 21 R. 12W

Well No. 6 Fischer "A"


Republic Natural Gas Company

COMPLETE Contractor

El, 1890

C N L SW NW

SECTION PLAT

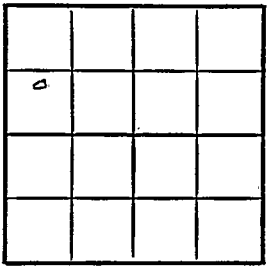

Ft. from N. Line

990 Ft. from S. Line

Ft. from E. Line

660 Ft. from W. Line

Stafford County

Location

Rig up

Drilling and Remarks:

Cd 3604

7" @ 3604

500 acid

Pump 84 BO.

40 - Gr

RECORD

Cased in., ft.

Sand

Gas

Oil

Total Depth 3610

PRODUCTION

1st 24 hrs. Nat.

1st 24 hrs. after shot

Gas Cu. Ft.


Dry Hole

Abandoned

Date

FEB 19 1947 19

S. J. LEWIS Scout

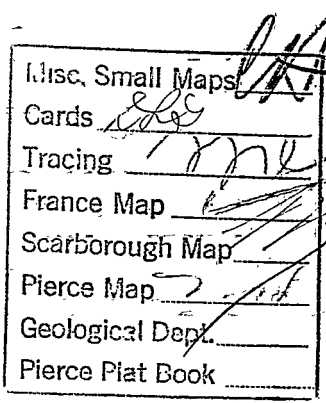
Misc. Small Maps
Cards
Tracing
France Map
Scarborough Map
Pierce Map
Geological Dept.
Pierce Plat Book