


KANSAS

Stafford county

Section 29 Township 21 Range 12- W

Well No. #3, Mueller


Company Isern Brothers

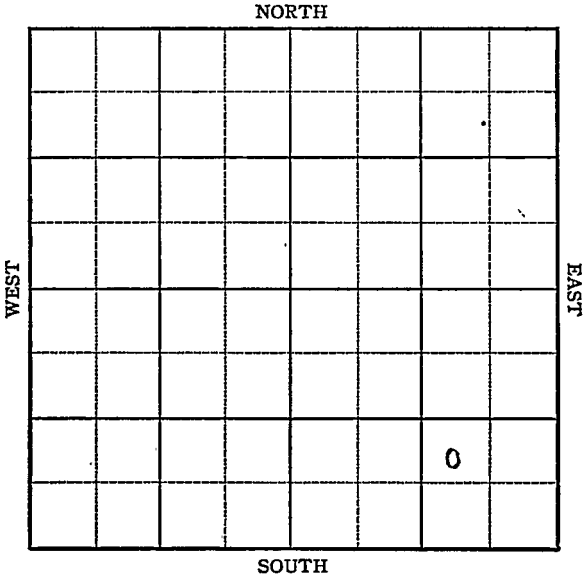

Sec. 29 Twp. 21 R. 12W

Well No. #3 Mueller Farm
Isern Bros. Company
Mueller

Ft. from N. Line
990 Ft. from S. Line
990 Ft. from E. Line
Ft. from W. Line

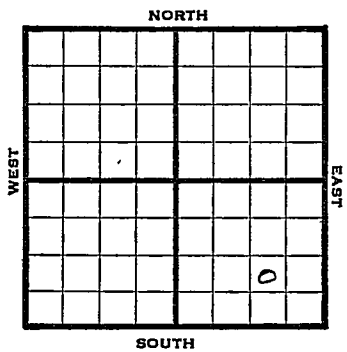

NW SE SE

1946

Elev. 1860' REPORT

11/6

8" @ 280'
Drlg 1530'

11/12

Lans 3256'
Viola 3482'
Simp 3521'
Arb 3571-72 TD
5" @ 3571, RUST

11/20

" "

11/27

TD 2583'

12/4

Arb 3571'
5" @ 3571'
TD 3583'
1000 Acid
Depth Pot 725
39.3 Grav.

COMPLETED

