


Section 29 Township 21 Range 12W

Well No. #4 Mueller

Company Isern Bros.

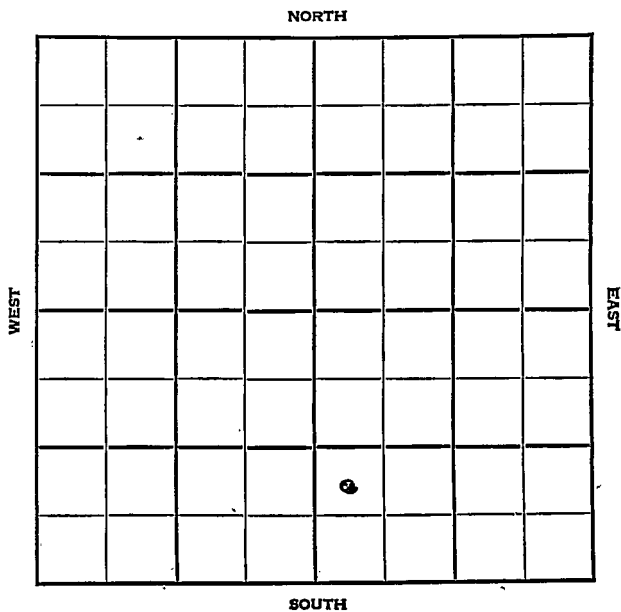

KANSAS


Stafford

Sec. 29 Twp. 21 R. 12W ✓Well No. #4 Mueller FarmIsern Bros. Company

Mueller

 Ft. from N. Line990 Ft. from S. Line Ft. from E. Line330 Ft. from W. Line

NW SW SE

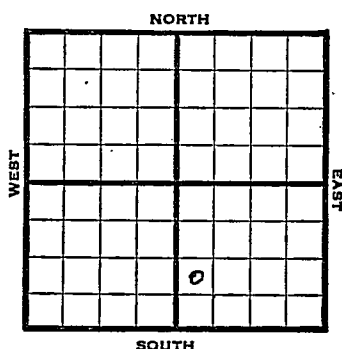

1948

Elev. 1864' REPORT

1/28 Drlg. 1975'

2/4 8" @ 282'
Lansing 3267'
Viola 3496'
Simpson 3536'
Arbuckle 3589'
TD 3590'
Run 5"2/11 5" @ 3587'
RUST

2/18 500 acid swb 12 bbls oil PH

2/25 Arb. 3587'
5" @ 3587'
500 acid
Pump. 208 Pot
40.0 Gr.
TD 3590'
Comp.

COMPLETED

Map No. _____ Sec. 29 Twp. 21 R. 12W

Well No. 4 Mueller

Isern Bros. Company

FIRST REPORT Contractor

NW SW SE


SECTION PLAT

_____ Ft. from N. Line

990 Ft. from S. Line

_____ Ft. from E. Line

330 Ft. from W. Line

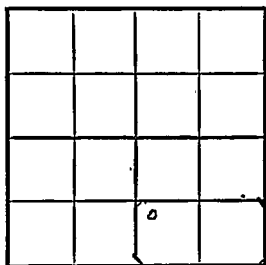

Stafford County

Location _____

Rig up _____

Drilling and Remarks:

drlg. 1975

RECORD

Cased _____ in., _____ ft.

Sand _____

Gas _____

Oil _____

Total Depth _____

PRODUCTION

1st 24 hrs. Nat. _____

1st 24 hrs. after shot _____

Gas _____ Cu. Ft.

Dry Hole _____

Abandoned _____

Date

JAN 28 1948

19

S. J. LEWIS

Scout

Map No. 46 Sec. 29 Twp. 21 R. 12W

Well No. 4 Mueller

Isern Bros. Company

COMPLETE

Contractor

NW SW SE

E 1, 1864
SECTION PLAT

 Ft. from N. Line

990 Ft. from S. Line

 Ft. from E. Line

330 Ft. from W. Line

		6	

Stafford County

Location

Rig up

Drilling and Remarks:


RECORD

Cased in., ft.

Sand

Gas

Oil

Total Depth 0870

PRODUCTION

1st 24 hrs. Nat.

1st 24 hrs. after shot

Gas Cu. Ft.

Dry Hole

Abandoned

Date

FEB 25 1948 19 S. J. LEWIS Scout