


Section 29 Township 21 Range 12W

Well No. 2 Tieperman

Company Virginia Drdg.

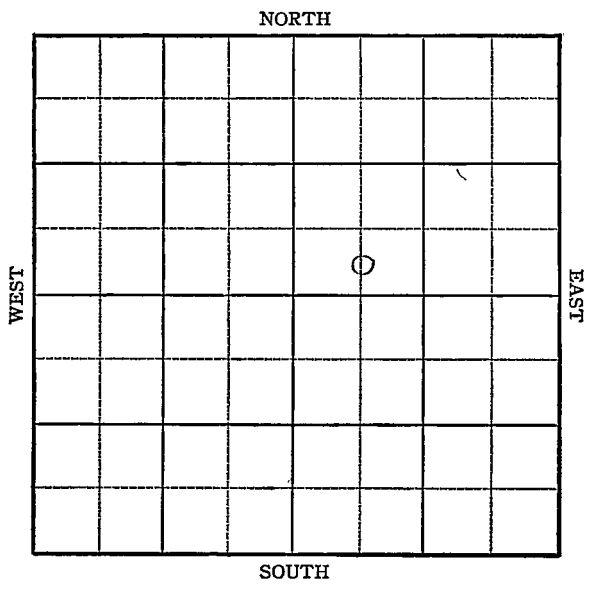

KANSAS

Stafford County

Sec. 29 Twp. 21 R. 12W

Well No. #2 Tieperman Farm

Virginia Drlg. Company

Fischer


_____ Ft. from N. Line

330 Ft. from S. Line

_____ Ft. from E. Line

660 Ft. from W. Line

CSL SW NE Elev. 1859

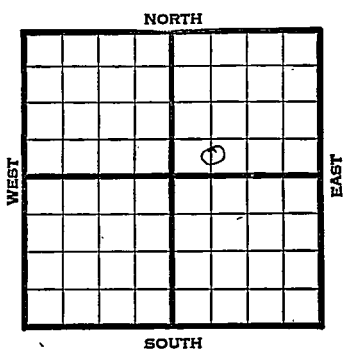

1945

REPORT

7/25 8" @ 672' WOC
 8/1 Anhy 658
 Drlg. 2898
 8/8 Lans 3261
 Viola 3491
 Simp 3536
 Arb. 3582
 TD 3584
 5" @ 3582 RUST
 8/15 " " "
 8/22 TD 3584
 2500' oil 14 hrs.
 8/29 " " "
 9/5 " " "
 9/12 " " "
 9/19 " " "
 9/26 Arb. 3582
 5" @ 3582
 TD 3584'
 Pump 121 Pot.
 Grav. 39.0

COMPLETED

KANSASPool Name FischerMap No. 46 Sec. 29 Twp. 21 R. 12WWell No. 2 Tieperman

Virginia Drlg. Company

FIRST REPORT

Contractor

C S E SW NE

SECTION PLAT

		o	

_____ Ft. from N. Line

330 Ft. from S. Line

_____ Ft. from E. Line

660 Ft. from W. Line

Stafford County

Location _____

Rig up _____

Drilling and Remarks:

8"-276 WOC**RECORD**

Cased _____ in., _____ ft.

Sand _____

Gas _____

Oil _____

Total Depth _____

PRODUCTION

1st 24 hrs. Nat. _____

1st 24 hrs. after shot _____

Gas _____ Cu. Ft.

Dry Hole _____

Abandoned _____

Date

JUL 25 1945 19S. J. LEWIS Scout

KANSAS Kansas Pool Name FischerMap No. 46 Sec. 29 Twp. 21 R. 12WWell No. 2 Tieperman

Virginia Drlg.

Company

COMPLETED

Contractor

C S L SW NE

E1, 1859
SECTION PLAT

		o	

_____ Ft. from N. Line

330 Ft. from S. Line

_____ Ft. from E. Line

660 Ft. from W. Line

Stafford County

Location _____

Rig up _____

Drilling and Remarks:

*CR 83582**5' 03582**Pump 121 P.D.**39° SW*

RECORD

Cased _____ in., _____ ft.

Sand _____

Gas _____

Oil _____

Total Depth 02584

PRODUCTION

1st 24 hrs. Nat. _____

1st 24 hrs. after shot _____

Gas _____ Cu. Ft.

Dry Hole _____

Abandoned _____

Date

SEP 26 1945

19

S. J. LEWIS

Scout