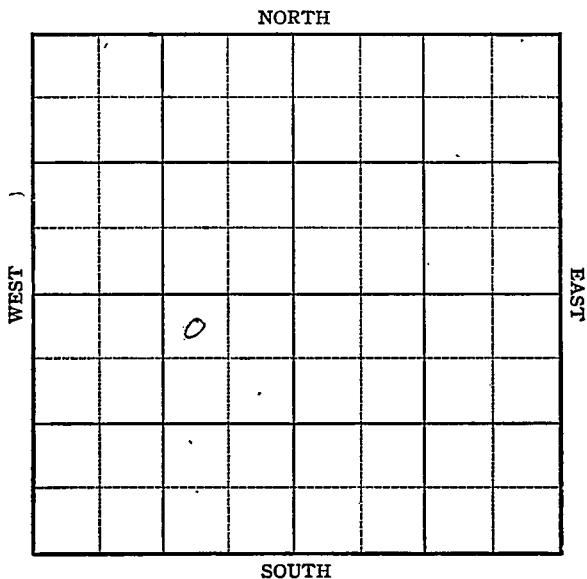


~~KANSAS~~

Stafford county

Section 29 Township 21 Range 12-WWell No. #6, TiepermannCompany Virginia Drilling

KANSAS


Stafford county ✓

Sec. 29 Twp. 21 R. 12-WWell No. #6, Tiepermann FarmVirginia Drlg. Company

Sittner

330' Ft. from N. Line Ft. from S. Line990' Ft. from E. Line Ft. from W. Line

NW NE SW

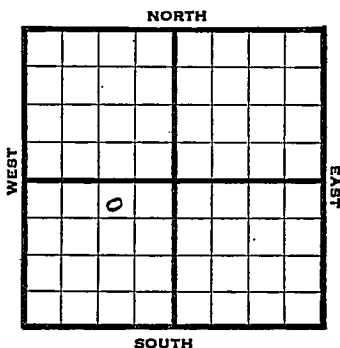

1946

1861

REPORT

10/2

8" @ 301'

WOC.

10/8

Drlg 1990'

10/15

Lans 3265'

Drlg 3310'

10/22

Viola 3487',

Simp sd 3568'

Arb 3570-72 TD

5" @ 3572' RUST

10/29

"

"

11/6

"

"

11/12

TD 3578 $\frac{1}{2}$

2650 oil, 12 hrs.

11/20

"

"

11/27

"

"

12/3

"

"

12/10

"

"

12/17

"

"

1947

1/4

TD 3578 $\frac{1}{2}$ - 2600 oil 12 hrs

1/8

"

"

"

1/15

"

"

"

1/21

"

"

"

OVER

1/29 TD 3578 $\frac{1}{2}$:
Arb 3570
5" :@ 3572
Pump 45 Pot
38 Gravity

COMPLETED

KANSAS ~~Kansas~~ Pool Name SittnerMap No. 46 Sec. 29 Twp. 21 R. 12WWell No. 6 TiepermannVirginia Drlg. CompanyFIRST REPORT Contractor

NW NE SW

SECTION PLAT

	o		

330 Ft. from N. Line Ft. from S. Line990 Ft. from E. Line Ft. from W. LineStaffordLocation Rig up

Drilling and Remarks:

8" @ 310' WOC

RECORD

Cased in., ft.Sand Gas Oil Total Depth

PRODUCTION

1st 24 hrs. Nat. 1st 24 hrs. after shot Gas Cu. Ft.Dry Hole Abandoned

Date

OCT 2 1946 19S. J. LEWIS Scout

Misc. Small Maps

Cards

Tracing

France Map

Scarborough Map

Pierce Map

Geological Dept.

Pierce Flat Tank

Map No. 46 Sec. 29 Twp. 21 R. 12W

Well No. 6 Tiepermann

Virginia Drlg.

Company


COMPLETE

Contractor

NW NE SW

E. 1761

SECTION PLAT

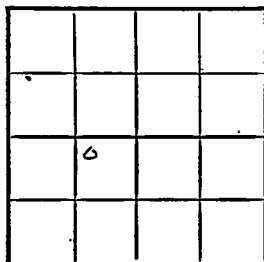

330 Ft. from N. Line

_____ Ft. from S. Line

990 Ft. from E. Line

_____ Ft. from W. Line

Stafford County

Location _____

Rig up _____

Drilling and Remarks:

2283570

5" 23572

Run 45 ft

35° S

RECORD

Cased _____ in, _____ ft.

Sand _____

Gas _____

Oil _____

Total Depth *3578 1/2*

PRODUCTION

1st 24 hrs. Nat. _____

1st 24 hrs. after shot _____

Gas _____ Cu. Ft.

Dry Hole _____

Abandoned _____

Date

JAN 29 1947 19

S. J. LEWIS Scout

Misc. Small Maps	<i>CS</i>
Cards	<i>SS</i>
Tracing	<i>ms</i>
France Map	<i>[scribble]</i>
Scarborough Map	<i>[scribble]</i>
Pierce Map	<i>[scribble]</i>
Geological Dept.	<i>[scribble]</i>
Pierce Plat Book	<i>[scribble]</i>