


Stafford county

Section 29 Township 21 Range 12-W

Well No. #7, Tiepermann

Company Virginia Drilg.

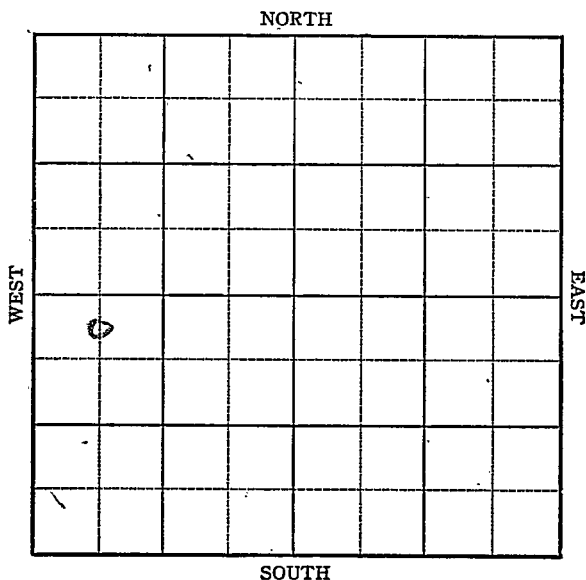

KANSAS

Sec. 29 Twp. 21 R. 12-W

Well No. #7, Tiepermann Farm

Virginia Drlg. Company

Sittner Pool


330' Ft. from N. Line

 Ft. from S. Line

 Ft. from E. Line

660' Ft. from W. Line

C N L NW SW

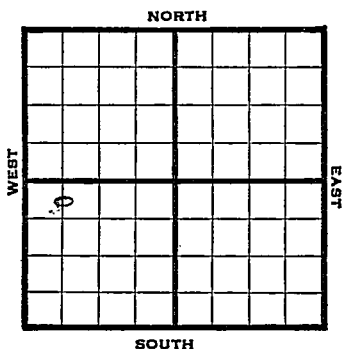

1946	Elev. 1865 REPORT
10/30	8" @ 297'
	Drlg. 2685'
11/6	Lans 3258'
	Viola 3493'
	Arb 3580*82 TD
	5" @ 3582', RUST
11/12	1300' fluid 2 hrs
11/20	TD 3585'
	1500' oil
11/27	" "
12/3	" "
12/10	" "
12/17	" "
12/19	" "
1947	
1/4	TD 3585, 1500' oil
1/8	" "
1/15	" "
1/21	" "
1/29	TD 3585'
	Arb 3580
	5" @ 3582
	Pump 99 Pot
	38 Gravity

COMPLETED

Map No. 46 Sec. 29 Twp. 21 R. 12WWell No. 7 TiepermannVirginia Drlg. Company

FIRST REPORT

Contractor

C N L NW SW

SECTION PLAT

0			

330 Ft. from N. Line Ft. from S. Line Ft. from E. Line660 Ft. from W. Line

Stafford County

Location Rig up

Drilling and Remarks:

8" @ 297

drlg. 2685

RECORD

Cased in., ft.Sand Gas Oil Total Depth


PRODUCTION

1st 24 hrs. Nat. 1st 24 hrs. after shot Gas Cu. Ft.Dry Hole Abandoned

Date

OCT 30 1946 19 S. J. LEWIS Scout

18 145

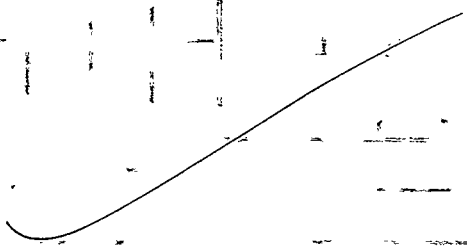

Misc. Small Maps	<u>[initials]</u>
Cards	<u>[initials]</u>
Tracing	<u>[initials]</u>
France Map	<u>[initials]</u>
Scarborough Map	<u>[initials]</u>
Pierce Map	<u>[initials]</u>
Geological Dept.	<u>[initials]</u>
Pierce Plat Book	<u>[initials]</u>

Map No. 26 Sec. 29 Twp. 21 R. 12W

Well No. 7 Tiepermann

Virginia Drlg. Company

COMPLETE

Contractor

C N L N W S W

E. 1865
SECTION PLAT

330 Ft. from N. Line

 Ft. from S. Line

 Ft. from E. Line

660 Ft. from W. Line

0			

Stafford County

Location

Rig up

Drilling and Remarks:

See 40580

5-03082

Pump 99.50

38-1/2

RECORD

Cased in., ft.

Sand

Gas

Oil

Total Depth 3575

PRODUCTION

1st 24 hrs. Nat.

1st 24 hrs. after shot

Gas Cu. Ft.

Dry Hole

Abandoned

Date

JAN 29 1947 19

S. J. LEWIS

Scout

Misc. Small Maps

Cards

Tracing

France Map

Scarborough Map

Pierce Map

Geological Dept

Pierce Plot Book