


Section 29 Township 21 Range 12-W
Well No. #8 Peterman A
Company Virginia Drlg.

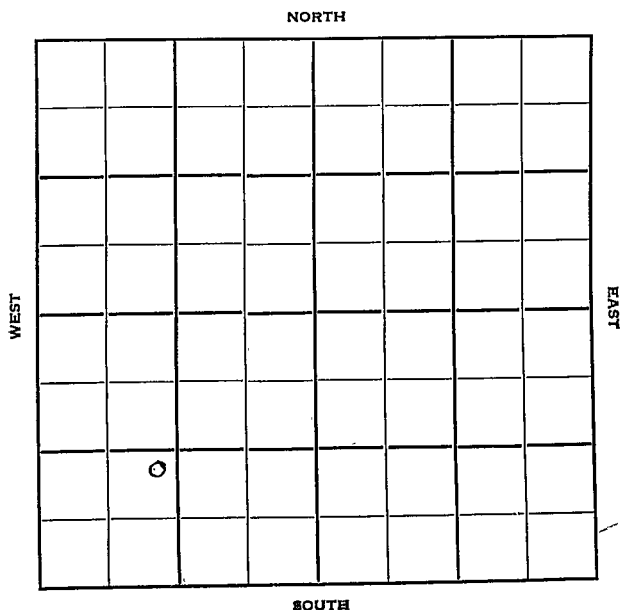

Stafford

KANSAS

Sec. 29 Twp. 21 R. 12W

Well No. #8 ~~Peterman~~ Dieterman "A" Farm

Virginia Drlg.

Company

Contractor

Mueller Pool

Ft. from N. Line

1280'


Ft. from S. Line

Ft. from E. Line

1280'

Ft. from W. Line

NE SW SW

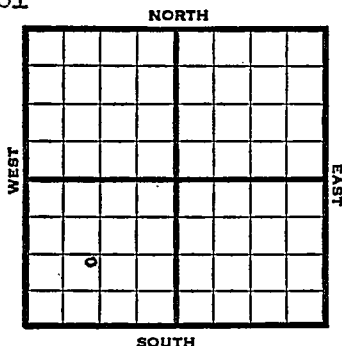

1950

Elev. 1861' REPORT

7/5

Location

12/6

8-5/8" @ 293' Anhy 660-90

KC 3254' Top 2741 Lans. 3244

Arb. 3597 TD 3651'

5" @ 3651' 12/3594-98

FU 150' oil in 30 min

12/3602-04 6/3610-12 FU 1500' oil
in 4 hr.

10 BOPD

COMPLETED

Kansas

Map No. _____ Sec. 29 Twp. 21 R. 12WWell No. 8 Peterman

_____ Virginia Drilling _____ Company

_____ Contractor

NE SW SW

SECTION PLAT

_____ Ft. from N. Line

1280 Ft. from S. Line

_____ Ft. from E. Line

1280 Ft. from W. Line

Stafford County

Location X

Rig up _____

Drilling and Remarks:

RECORD

Cased _____ in., _____ ft.

Sand _____

Gas _____

Oil _____

Total Depth _____

PRODUCTION

1st 24 hrs. Nat. _____

1st 24 hrs. after shot _____

Gas _____ Cu. Ft.

Dry Hole _____

Abandoned _____

Date

JUL 5 1950

19

J. E. TYRA

Scout

Map No. _____ Sec. 29 Twp. 21 R. 12W


Well No. 8 Tieperman "A"

Virginia Drlg. _____ Company

Contractor

NE SW S^W

SECTION PLAT

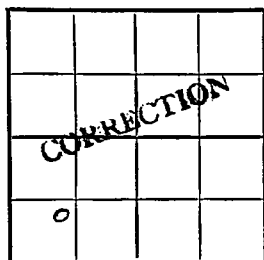

_____ Ft. from N. Line

1280 Ft. from S. Line

_____ Ft. from E. Line

1280 Ft. from W. Line

Stafford County

Location _____

Rig up _____

Drilling and Remarks:

Reported

#8 Peterman

RECORD

Cased _____ in., _____ ft.

Sand _____

Gas _____

Oil _____

Total Depth _____

PRODUCTION

1st 24 hrs. Nat. _____

1st 24 hrs. after shot _____

Gas _____ Cu. Ft.

Dry Hole _____

Abandoned _____

Date

JUL 12 1950 19 J. E. TYRA Scout

County Stafford State Kansas

Sec. 29 (Blk. Twp.) 21 (Sur. Rge.) 12W Map No.

Operator Virginia Drle.

Well No. 8 Farm Tieperman "A"

Elev. 1861 Location NE SW SW

COMPLETE

1280 Ft. From S Line SW

1280 Ft. From W Line Quarter

1st. Report

Completion DEC 6 1950

Remarks Mueller Pool

Spudding Date

Drlg. Data

8 5/8" @ 293 Anhy 660-90 KC 3254

Top. 2741 Kans. 3244 Arb. 3597

TD 3651 5" @ 3651 12/ 3594-98

FU 150' oil in 30 min. 12/ 3602-04

6/ 3610-12 FE 1500' oil in 4 hr.

DEC 6 1 OCT 25 NOV 1 NOV 8 NOV 15 NOV 22 NOV 29

10 BOPD

J. E. TYRA