OWWO

FORM 5V 25M 8-50 WESTERN Stafford KANSAS

Section 29 Township 21 Range 13 W

Well No. # 2 Essmiller

Company Cities Service Oil

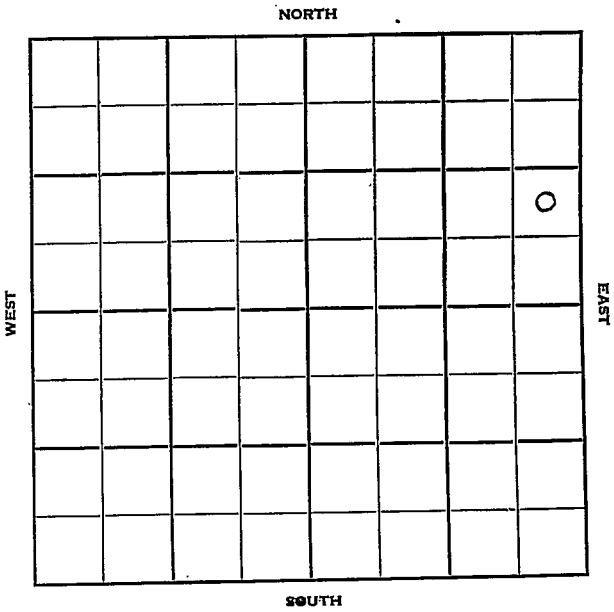

FORM 275 FOR SALE BY KANSAS BLUE PRINT CO.

County Stafford State Kansas

Sec. 29 (Blk. Twp.) 21 (Sur. Rge.) 13W Map No.

Operator Cities Service

Well No. 2 Farm Essmiller

Elev. Location NE SE NE

							O

FIRST REPORT

990 Ft. From S Line NE

330 Ft. From E Line Quarter

1st. Report MAY 9 1951

Completion

Remarks

Barbour - Contr.

Spudding Date 5-6-51

Drlg. Data

8" @ 357 WOC

J. E. TYRA

FORM 275 FOR SALE BY KANSAS BLUE PRINT CO.

County Stafford State Kansas

Sec. 29 (Blk. Twp.) 21 (Sur. Rge.) 13W Map No.

Operator Cities Service

Well No. 2 Farm Essmiller

Elev. 1906 Location NE SE NE

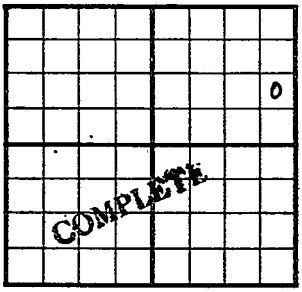

990 Ft. From S Line NE

330 Ft. From E Line Quarter

1st. Report

Completion JUN 13 1951

Remarks

Barbour - Contr.

Spudding Date 5-6-51

Drlg. Data Oil well TD 3714

8" @ 357 Br. lime 3344 Lans.3396

Cong. 3611 Viola 3618 Simp. 3658

Arb. 3711 TD 3713 5" @ 3712

TD 3714 500 A Comp. 336 bopd

J. E. TYRA