

O. W. P. B.

Section 29 Township 21 Range 13WWell No. 1 Essmiller "B"Company Cities Service Oil

NORTH

0							

WEST

EAST

SOUTH

Sec. 29 Twp. 21 R. 13W N 1


Well No. #1 Essmiller "B" Farm

Cities Service Oil Company

Eden Valley Pool Contractor


Ft. from N. Line
330' Ft. from S. Line
Ft. from E. Line
330' Ft. from W. Line

SW SW NW

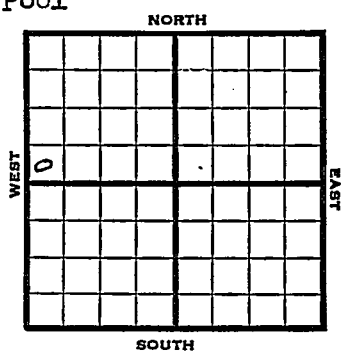

1951	Elev. 1914' REPORT
7/17	Location
8/29	<p>Spud 7-19-51</p> <p>Oil well TD 3721' 8" @ 366</p> <p>Br. lime 3355' Lans. 3373'</p> <p>Cong. 3611' Viola 3627'</p> <p>Simp. 3664' Arb. 3718-20'</p> <p>5" @ 3718' TD 3721' FU 2625'</p> <p>oil 20 hr. P/43 BO 7 hr.</p> <p>Comp. 223 BOPD</p> <p>COMPLETED</p>
1954	O. W. P. B.
3/17	<p>Oil well TD 3721' Lans. 3374</p> <p>Arb. 3719 5" @ 3719 OTD 3721</p> <p>PB 3593 35/3546-56 35/3505-15</p> <p>32/3486-95 2000 A</p> <p>Comp. 847 BOPD</p> <p>FIRST REPORT</p> <p>COMPLETED</p>

W. E. TYRA

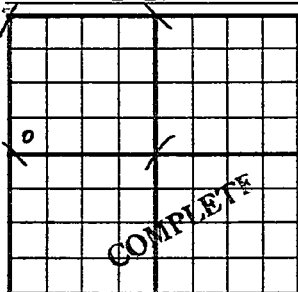County Stafford State KansasSec. 29 (Blk.) 21 (Sur.) 13W Map No.Operator Cities ServiceWell No. 1 Farm Essmiller "B"Elev. 1914 Location SW SW NW330 Ft. From S Line NW330 Ft. From W Line Quarter1st. ReportCompletion AUG 29 1951Remarks Eden Valley PoolSpudding Date 7-19-51Drig. Data Oil well TD 37218" @ 366 Br. lime 3355 Lans. 3373Cong. 3611 Viola 3627 Simp. 3664Arb. 3718-20 5" @ 3718 TD 3721FU 2625' oil 20 hr. P/ 43 bo 7 hr.Comp. 223 bopd

O. W. P. B.

County **Stafford** State **Kansas**

Sec. 29 (Blk. Twp.) 21 (Sur. Rge.) 13W Map No.

Operator Cities Service

Well No. **1** Farm **Essmiller "B"**

Elev. 1914 Location SW SW NW

FIRST REPORT

0

COMPLETE

330 Ft. From S Line NW

330 Ft. From W Line Quarter

1st. Report **MAR 17 1954**

Completion MAR 17 1954

Remarks. (OWPB)

~~C. W. P. B.~~

Drilg. Data Oil well TD 3721

Lens. 3374 Arb. 3719 5" @ 3719 OTD 3721

PB 3593 35/ 3546-56 35/ 3505-15

32/ 3486-95 2000 A

Comp. 847 bopd

J. G. McGEHEE