

Sec. 29 Twp. 21 R. 13W

Well No. #1 John Keenan Farm

Petroleum, Inc. Company

Contractor


 Ft. from N. Line

990' Ft. from S. Line

 Ft. from E. Line

990' Ft. from W. Line

NE SW SW

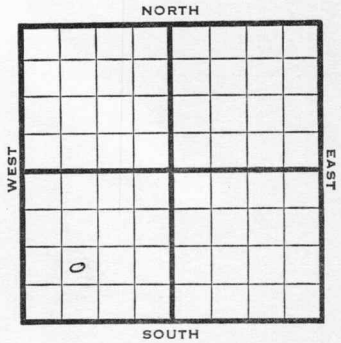

1950 Elev 1911' REPORT

4/19 8" @ 228'
Anhy 790-822
Drlg. 2122'

5/3 TD 3768'
8" @ 228'
Arb. 3751'
D&A
Aband.

ABANDONED

Kansas

Map No. _____ Sec. 29 Twp. 21 R. 13W

Well No. 1 John Keenan

Petroleum Inc. Company

Contractor

NE SW SW

SECTION PLAT



_____ Ft. from N. Line

990 Ft. from S. Line

_____ Ft. from E. Line

990 Ft. from W. Line

Stafford County

Sunray farmout

Location _____

Rig up _____

Drilling and Remarks:

8" @ 228

Anhy 790-822

drlg. 2122

RECORD

Cased _____ in., _____ ft.

Sand _____

Gas _____

Oil _____

Total Depth _____

PRODUCTION

1st 24 hrs. Nat. _____

1st 24 hrs. after shot _____

Gas _____ Cu. Ft.

Dry Hole _____

Abandoned _____

Date

APR 19 1950

19

J. E. TYRA

Scout

Map No. _____ Sec. 29 Twp. 21 R. 13W

Well No. 1 John Keenan

Petroleum Inc. Company

Contractor

NE SW SW

E/ 191'
SECTION FLAT

_____ Ft. from N. Line

990 Ft. from S. Line

_____ Ft. from E. Line

990 Ft. from W. Line



Stafford County

Location _____

Rig up _____

Drilling and Remarks:

*8" @ 228
arb 3751
D & A*

RECORD

Cased _____ in., _____ ft.

Sand _____

Gas _____

Oil _____

Total Depth 3768

PRODUCTION

1st 24 hrs. Nat. _____

1st 24 hrs. after shot _____

Gas _____ Cu. Ft.

Dry Hole _____

Abandoned _____

Date

MAY 3 1950

19

J. E. TYRA

Scout