


Section 29 Township 21 Range 13W

Well No. 2 Essmiller "A"

Company C.S. O.

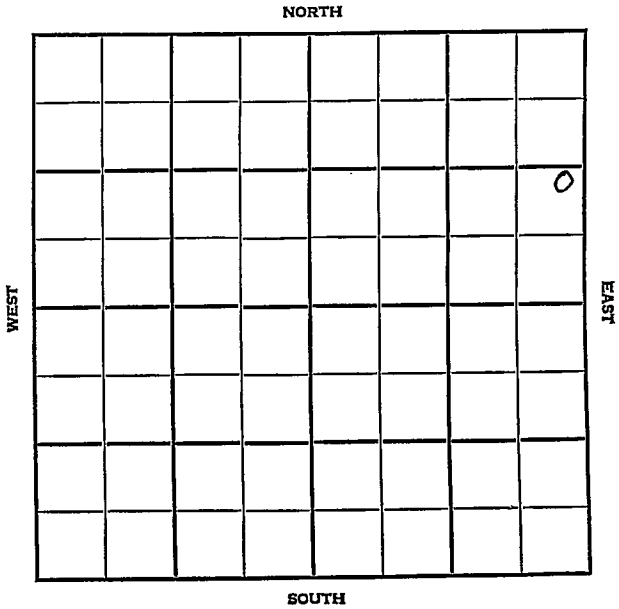

O.W.W.O.

Stafford

KANSAS

Sec. 29 Twp. 21 R. 13 W

Well No. # 2 Essmiller "A" Farm

Cities Service Oil Company

Barbour Contractor

Hazel Pool


Ft. from N. Line

990 Ft. from S. Line

330 Ft. from E. Line

Ft. from W. Line

NE SE NE

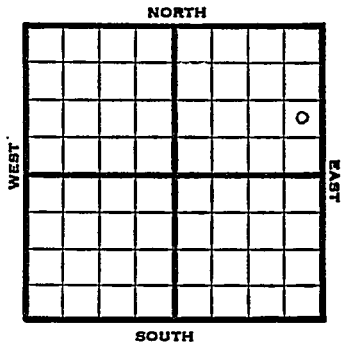

1951

Elev. 1906' REPORT

5/9

Spud 4-6-51
8" @ 357 WOC

6/13

Spud 5-6-51
Oil Well TD 3714
8" @ 357 Br Lime 3344
Lans. 3396 Cong. 3611
Viola 3618 Simp 3658
Arb. 3711
TD 3713 5" @ 3712
TD 3714 500 A
Comp. 336 bopd

~~COMPLETE~~

1955

O.W.W.O.

7/20

Old Info: OTD 3715' 5" @ 3709
Was Arb. prod.
NEW INFO: PB 3589' 65 shots/3415-
32. 1000 A Phy Pot 295 BO + 5 BW
24 hrs. Comp.

FIRST REPORT

COMPLETED

O.W.W.O.
O.W.W.O.

FORM 513 REV. SUNRAY

County Stafford Elev. _____
 Sec. 29 Twp. 015 Rge. 13W
 Company C.S.O.
 Farm Name Esmliller "A" No. 2

TOPS	DEPTH	LOG	DATUM
Anh.			
Tp.			
H.			
Tr.			
Dg.			
BL.			
L.	3396		
K.C.			
B.K.C.			
Cp.	3608		
C.			
M.			
M.			
K.			
Mz.			
Mo.			
V.	3615		
S.	3658		
S.			
A.			
R.			
PE.			
G.			
T.D.			

Loc. in Sec. _____
 NE SE NE
 Geol. _____
 Contr. _____
 Pool _____
 Hazel

COMPLETE
 JUL 20 1961
FIRST REPORT

Date Comm. _____
 Old info: OTD 3715; 5" 3709 - was Arb prod
 New info: PB 3589 65 shots 3415-32 1000A
Phy Pot. 295 bo plus 5 bw/24 hrs.
 Comp. _____

Co.
Lse.
No.
Sec.
T.
R.