


Section 29 Township 21 Range 13W

Well No. #2 Keller "A"

Company Petroleum Inc.

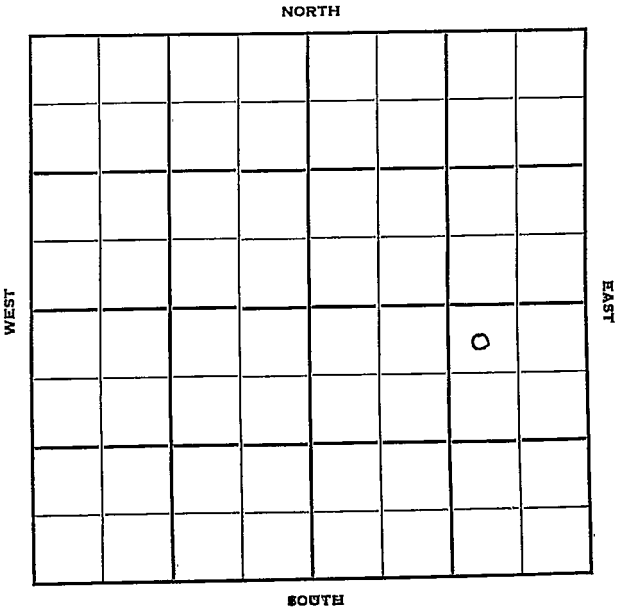

Sec. 29 Twp. 21 R. 13W

Well No. #2 Keller "A" Farm

Petroleum, Inc. Company

Garvey Contractor

Fischer Pool


330' Ft. from N. Line

Ft. from S. Line

990' Ft. from E. Line

Ft. from W. Line

NW NE SE

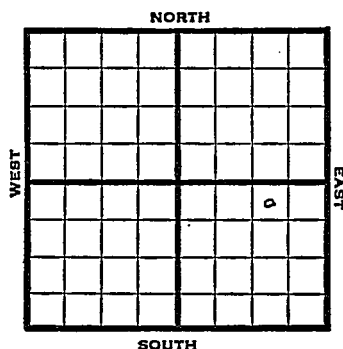


1950 Elev 1908 REPORT

9/27 Spud 9-19-50
8-5/8" @ 212'
Drlg. 3180'

11/15 8 5/8" @ 212
Heeb 3225 Br lime 3349
Lans 3362
DST 3379-95 opn 60 min rec 120' m & g
oil
DST 3402-55 opn 1 hr rec 270' muddy w
water 600' oily water
DST 3505-22 opn 1 hr rec 1620' water
Cong 3620 Ch Viola 3622
Simp sh 3671 Arb 3717-67
5" @ 3766
6/3744-46
S/1 bwph SP 3740
6/3718-20
S/ 1 bwph SP 3740
6/3718-20
8/3718-20 1 gwph 250A 6 3/4 bo
plug 10% water
Comp 30 bopd TD 3767
Completed
COMPLETED

J. E. TYRA

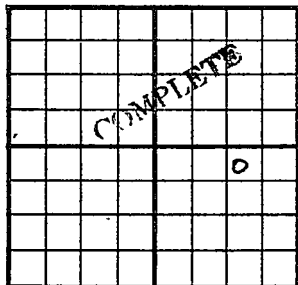County Stafford State KansasSec. 29 (Blk.) 21 (Sur.) 13W Map No.Operator Petroleum Inc.Well No. 2 Farm Keller "A"Elev. 1908 Location NW NE SE330 Ft. From N Line SE990 Ft. From E Line Quarter1st. ReportCompletion NOV 15 1950Remarks Fischer PoolGarvey - Contr.Spudding Date 9-19-50Drlg. Data Oil well TD 37678 5/8" @ 212 Heeb. 3225 Br. lime 3349Lens. 3362 DST 3379-95 open 60 min.Rec. 120' m & g oil DST 3402-55 open 1 hr.Rec. 270' muddy water 600' oily waterDST 3505-22 open 1 hr. Rec. 1620' waterCong. 3620 Ch. Viola 3622 Simp. sh. 3671Arb. 3717-67 5" @ 3766 6/ 3744-46S/ 1 bwph SP 3740 6/ 3718-208/ 3718-20 1 gwph 250 A 6 3/4 boplus 10% water Comp. 30 bopd

J. E. TYRA