


Section 29 Township 21 Range 13 WWell No. # 2 Keller "B"Company Petroleum Inc.

NORTH

WEST

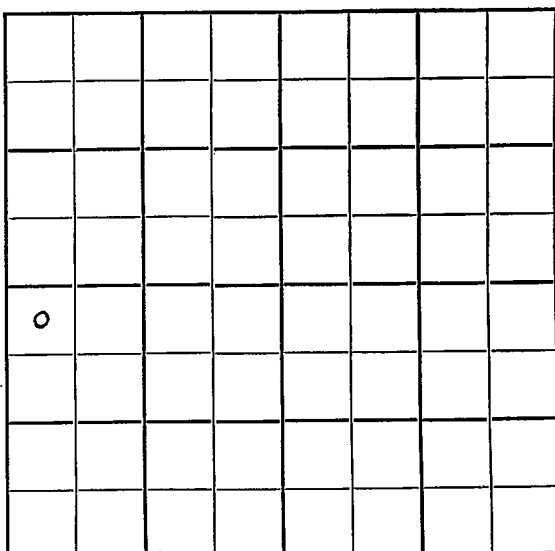

EAST

SOUTH

Sec. 29 Twp. 21 R. 13W

Well No. #2 Keller "B" Farm

Petroleum, Inc. Company

Contractor


330' Ft. from N. Line

_____ Ft. from S. Line

_____ Ft. from E. Line

330' Ft. from W. Line

NW NW SW

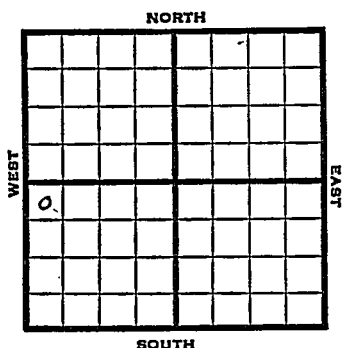

1951

Elev. 1911'

REPORT

3/28

Spud 3-19-51

8" @ 204'

Heeb. 3231

Br Lime 3357

Lans. 3368'

Drlg.

5/9

Spud 3-19-51

Oil Well TD 3770

8" @ 204

Heeb. 3231 Br lime 3357

Lans. 3368

DST 3410-62 opn 1 hr

Rec. 55' mud DST 3486-99 opn 1 hr

Rec. 52' wtr & mud

Viola 3625 Simp 3665'

Arb. 3719

DST 3720-23 opn 2 hr Rec. 62' hoem


TD 3770 5" @ 3762 24/3720-24

1000 A S/6 boph Comp. 168 bopd

COMPLETED

J. E. TYRA

County Stafford State Kansas
 Sec. 29 (Blk. 21 (Sur. 13W Map No.
 Twp.) Rge.)
 Operator Petroleum Inc.
 Well No. 2 Farm Keller "B"
 Elev. 1911 Location NWNW SW

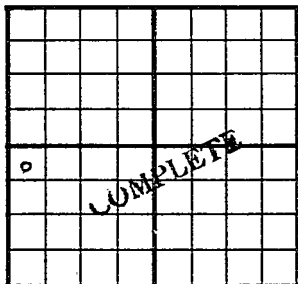

330 Ft. From N Line SW
330 Ft. From W Line Quarter
 1st. Report _____
 Completion MAY 9 1951
 Remarks _____

 Spudding Date 3-19-51

Drilg. Data Oil well TD 3770
8" @ 204 Heeb. 3231 Br. lime 3357
Lans. 3368 DST 3410-62 open 1 hr.
Rec. 55' mud DST 3486-99 open 1 hr.
Rec. 52' water & mud Viola 3625
Simp. 3665 Arb. 3719 DST 3720-23
open 2 hr. Rec. 62' hoem TD 3770
5" @ 3762 24/ 3720-24 1000 A
S/ 6 boph Comp. 168 bopd

J. E. TYRA