


O. W. P. B. Stafford

KANSAS

Section 29 Township 21 Range 13 W

Well No. # 4 Essmiller "A"

Company Cities Service

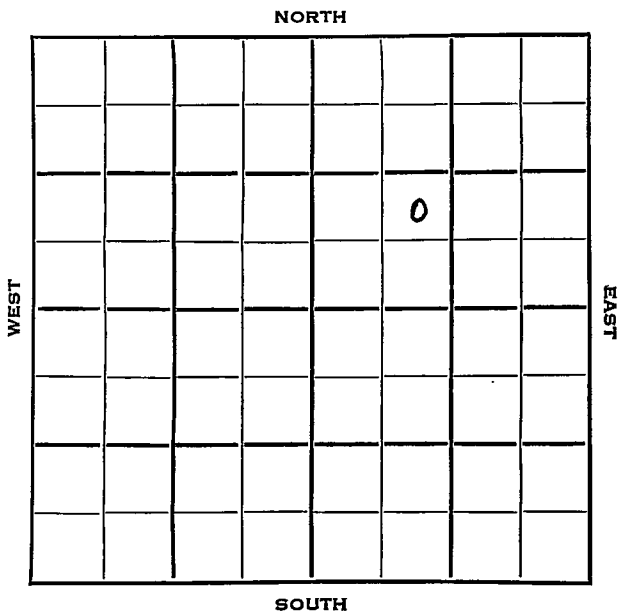

O. W. P. B.

Sec. 29 Twp. 21 R. 13W

Well No. #4 Essmiller "A" Farm

Cities Service Company

Holm Drlg. Contractor

Eden Valley Pool


 Ft. from N₂ Line

990 Ft. from S. Line

 Ft. from E. Line

990 Ft. from W. Line

NE SW NE

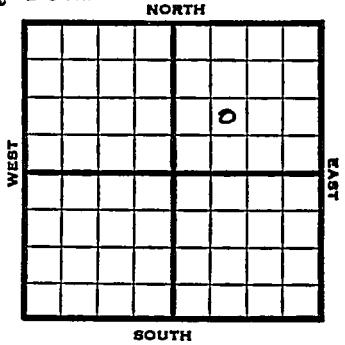

1953

Elev. 1908'

REPORT

6/3

Loc.

6/10

8" @ 354
Drlg. 2950

7/22

Spud 6-4-53
Oil Well
TD 3734
8" @ 354
Heeb 3235, Dodge 3257, Br lime 3361,
Lans 3374
DST 3400-09, opn 1 hr., rec. 35' mud,
40#
DST 3437-47, opn 1 hr., rec. 250' sw,
1260#
DST 3529-62, opn 1 hr., rec. 165' g &
ocm, 800#
B KC 3604, Cong 3625, Viola 3630, Simp
3681, Arb. 3728
DST 3729-34, opn 1 hr., rec. 1000' oil
200' ocm, & wtr., 1180#
TD 3734
5" @ 3730
CO to 3734
Comp. 195 bopd 231 bw

**COMPLETED
OVER**

1954

O. W. P. B.

12/15

Oil Well

TD 3734'

Plans 3374' Arb. 3728'

5" @ 3730'

OTD 3734'

PB 3596'

56/ 3529-43 45/ 3557-68 42/ 3492-

3504' 1000 A

Comp 17 bopd; 113 bw.

FIRST REPORT

✓

COMPLETED

JUN 5 1953

| |
|----------------------|
| Scout Cards |
| Land Small Map |
| Land Wall Map |
| Tracings |
| France Map |
| Pierce Map |
| Misc..... |

Orig. Data

JUL 29 1953

| | |
|----------------|----|
| Scout Cards | AD |
| Land Small Map | |
| Land Wall Map | B |
| Tracings | |
| France Map | |
| Pierce Map | |
| Misc. | |

