


Section 29 Township 21 Range 13W

Well No. #4 Essmiller (B)

Company Cities Service Oil

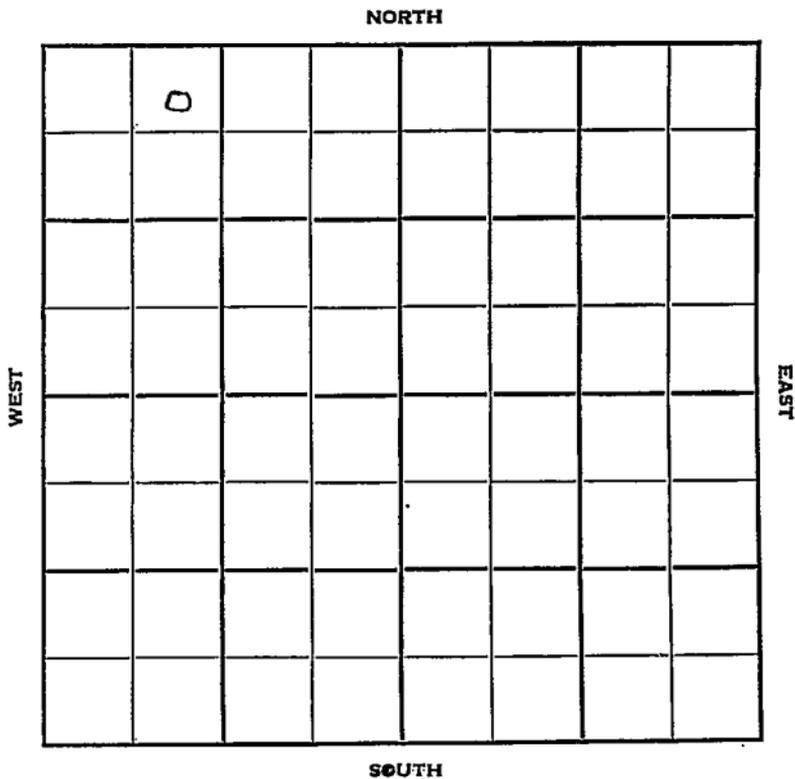

Stafford

KANSAS

Sec. 29 Twp. 21 R. 13W ✓

Well No. #4 Essmiller (B) Farm

Cities Service Oil Company

Contractor


330' Ft. from N. Line

_____ Ft. from S. Line

_____ Ft. from E. Line

990' Ft. from W. Line

NE NW NW

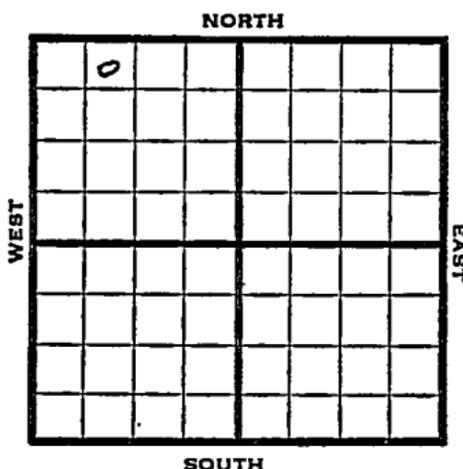

1952	Elev. 1909'	REPORT
2/6	Spud 2-2-52 8" @ 368 Drlg. 1915'	
2/13	Lans. 3361' DST 3388-3408', 1 hr, 85' GCM DST 3409-35, 1 hr, 120' OCM, 2040' oil, 1070# BHP Gr. 25.7 DST 3436-52, 1 hr, 75' OCM, 400' oil, 80' wtr. Drlg. 3460'	
2/20	DST 3480-94 1 hr. 70' HO&GCM 60" oil 60" M&GCO / 1209# DST 3494-3515 1 hr. 780' oil 600' SM&GCO 1243# Arb. 37066 TD 3707 Sch. 5" @ 3707'	
3/5	NR	
3/12	"	
3/19	"	
3/26	Spud 2-2-52 Oil well TD 3713' 8" @ 368' Lans. 3361' DST 3388-3408 open 1 hr. rec 85' GCM DST 3409-35 open 1 hr. rec 120' HO&GCM 2040' oil DST 3436-52 open 1 hr, gas in 40 min. rec 75' OCM, 400' oil, 80' water.	

OVER

1952
3/26

(Information continued)

DST 3480-94, open 1 hr. rec 70' HO
& GCM, 60' oil, 60' M & GCO

DST 3494-3515 open 1 hr. rec 780'
oil; 600' SC & GCO

Arb. 3706' TD 3707' 5" @ 3707'

DD 3713' FU "600' oil 1 hr,
3000' oil, 19 hr. P/214 BO 14 hr.

500 A B/206 BO 13 hr.

Comp. 1492 B^OPD

COMPLETED

County Stafford State Kansas

Sec. 29 (Blk.) 21 (Sur.) 13W Map No. (Twp.) (Rge.)

Operator Cities Service Oil

Well No. 4 Farm Essmiller (B)

Elev. _____ Location NE NW NW

0							

FIRST REPORT

330 Ft. From N Line NW

990 Ft. From W Line Quarter

Ist. Report FEB 6 1952

Completion _____

Remarks _____

Spudding Date 2-2-52

Drlg. Data _____

8" @ 368 Drlg. 1915

J. G. McGEHEE

Scout Cards	<input checked="" type="checkbox"/>
Land Small Map	<input type="checkbox"/>
Land Wall Map	<input checked="" type="checkbox"/>
Tracings	<input type="checkbox"/>
France Map	<input type="checkbox"/>
Pierce Map	<input type="checkbox"/>
Misc.	<input type="checkbox"/>

FEB 8 1972

County Stafford State Kansas
 Sec. 29 (Blk. 21) (Sur. 13W) Map No. _____
 Operator Cities Service Oil
 Well No. 4 Farm Essmiller "B"
 Elev. 1909 Location NE NW NW

0				

330 Ft. From N Line NW
990 Ft. From W Line Quarter

Ist. Report _____

Completion MAR 26 1952

Remarks _____

Spudding Date 2-2-52

Drilg. Data Oil well TD 3713

8" @ 368 Lans. 3361 DST 3388-3408

open 1 hr. Rec. 85' gcm DST 3409-35

open 1 hr. Rec. 120' hocm 2040' oil

DST 3436-52 open 1 hr. gas in 40 min.

Rec. 75' ocm 400' oil 80' water

✓ DST 3480-94 open 1 hr. Rec. 70' ho &

gcm 60' oil 60' m & gco DST 3494-3515

open 1 hr. Rec. 780' oil 600' sc & gco

Arb. 3706 TD 3707 5" @ 3707 DD 3713

FU 600' oil 1 hr. 3000' oil 19 hr.

P/ 214 bo 14 hr. 500 A B/ 206 bo 13 hr

Comp. 1492 bopd

J. G. McGEHEE

Scout Cards *mm*

Land Small Map

Land W^hl Map

.....

.....

Pierce Map

Misc.

APR 2 1952

Drig. Data