


Section 29 Township 21 Range 13 W

Well No. # 7 Essmiller "B"

Company Cities Service Oil

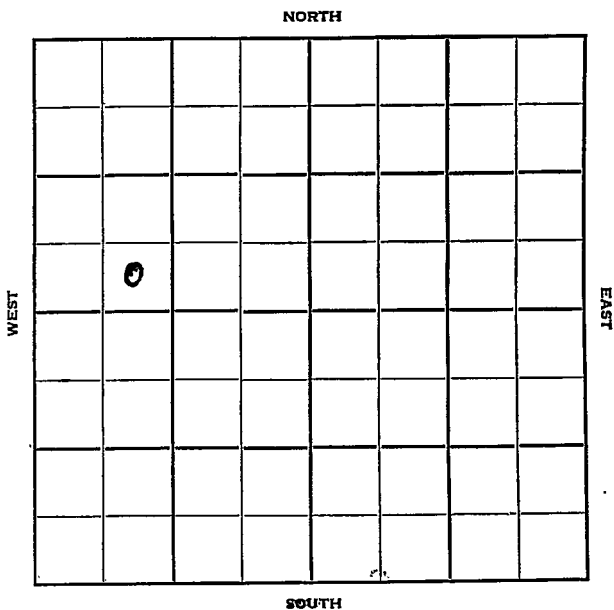

Sec. 29 Twp. 21 R. 13W

Well No. #7 Essmiller "B" Farm

Cities Service Oil Company

Contractor


_____ Ft. from N. Line

330 Ft. from S. Line

_____ Ft. from E. Line

990 Ft. from W. Line

SE SW NW

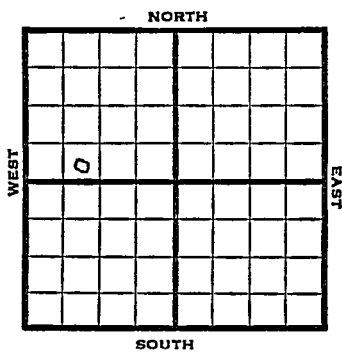

1952

Elev. 1911' REPORT

- 9/4 MIM
- 9/10 Drlg. 3105
- 9/17 Heeb. 3233 Dodge 3254
Lans. 3370
DST 3400-3418, 1 hr. 108' M & W
900#
DST 3489-3500, 1 hr. 75' OCM,
220' SW 900# Arb. 3713
RTD 3716' 5" @ 3714'
- 9/24 BKG 3596 Cherty Cong 3621
V 3625 Simp 3644
DD 3718 TD fill up 120' oil 15½
hrs.
- 10/1 380A 500 A P/ 102 B0 & 10 BW
13 hrs.
- 10/8 "
- 10/15 "
- 10/22 Spud. 9-3-52
Oil well TD 3718' 8" @ 361
Heeb 3233' Dodge 3254' Lans. 3370
DST 3400-3418' open 1 hr. rec 108'
mud & wtr. 900#
DST 3489-3500 open 1 hr. rec 75' OCM
220' SW 900#
Arb. 3713' TD 3716' 5" @ 3714
B KC 3596' Cong. 3621' Viola 3625'

OVER

1952

10/22

(Information continued)

Simp. 3644' DD 3718' FU 120'

oil, 15½ hr, 380 A 500 A

P/102 B0 10 BW 13 hr.

Comp. 288 BOPD 8% wtr.

COMPLETED

Scout Cards

Land Small Map

Land Wall Map

Tracings

France Map

Pierce Map

Misc

2210 8 1912

Dirg. Data



OCT 29 1952

Scout Cards	mm
Land Sma'l Map	
Land Van Map	
Things	
Home Map	
Print Map	
Misc.	

Orig. Data