


Section 29 Township 21 Range 13W

Well No. 9 Essmiller "B"

Company Cities Service

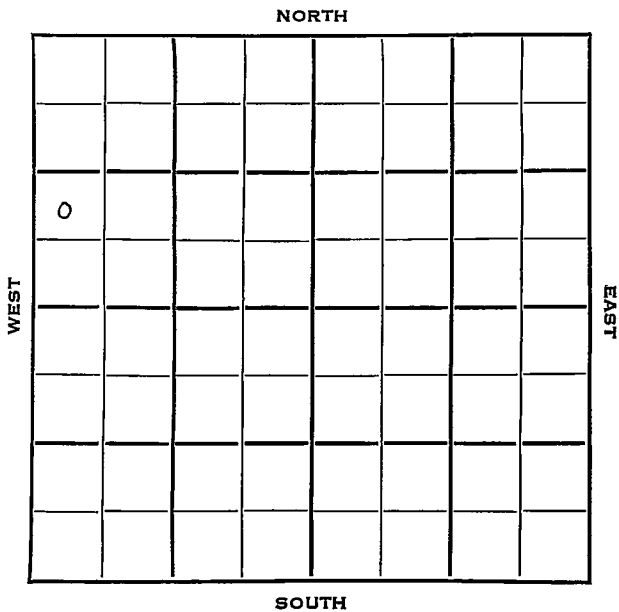

Stafford

KANSAS ✓

Sec. 29 Twp. 21 R. 13W

Well No. 9 Essmiller "B" Farm

Cities Service Company

Holm Drlg - Contr. Contractor

Eden Valley Pool


Ft. from N. Line

990 Ft. from S. Line

Ft. from E. Line

330 Ft. from W. Line

NW SW NW

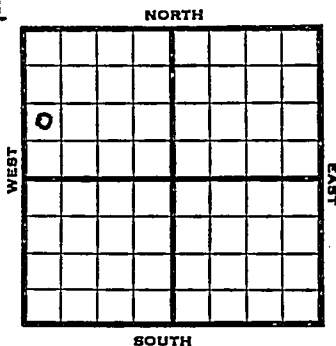

1953

Elev. 1911' REPORT

4/1 Spud 3-27-53
8" @ 363
Drlg 2170

4/9 "

4/16 NR

4/23 NR

4/29 Spud 3-27-53
Oil Well
TD 3716'
8" @ 363'
Lans 3356,
DST 3396-3417 opn 1 hr, rec 100' o &
gcm 80' gco 1025#
DST 3419-32 opn 1 hr, rec 34' ocm
120' muddy oil, 60' clean oil 1130#
DST 3435-49 opn 1 hr, rec 540' oil,
980#
DST 3476-88 opn 1 hr, rec 120' myddy
oil, 290' gassy oil, 960#
DST 3511-50 opn 1 hr, rec 2360' gco
220' mco 1140# B KG 3581, Cong 3609
Viola 3615, Simp 3667, Arb 3713,
TD 3715
5" @ 3714'
DD 3716 FU 1450' oil 22 hr. PB 3643
15/ 3532-46 24/ 3538-46 17/ 3532-38
70/ 3510-27 FU 1100' oil 3½ hr.
3000 A P/ 280 ho 17 hr.
Comp. 3000 bopd. **COMPLETED**

County Stafford State Kansas

Sec. 29 (Blk.) 21 (Sur. Rge.) 13W Map No.

Operator Cities Service

Well No. 9 Farm Essmiller "B"

Elev. _____ Location EW SW NW

0					
FIRST REPORT					

990 Ft. From S Line NW

330 Ft. From W Line Quarter

Ist. Report APR 1 1953

Completion _____

Remarks _____

Holm Drig. - Contr.

Spudding Date 3-27-53

Drlg. Data Eden Valley Pool

8" @ 363 drlg. 2170

APR 6 1953

Scout Cards	82
Land Small Map	
Land Wall Map	3
Tracings	
France Map	
Pierce Map	
Misc	

Orig. Data

Scout Cards
Land Small Map
Land Wall Map
Tracings
France Map
Pierce Map
Misc

MAY 6 1963

RP

Orig. Data
P/280 to 17 hr.
Comp. 3000 hppd