


Section 29 Township 21 Range 11W

Well No. #2 Lincoln

Company Pet. Inc.

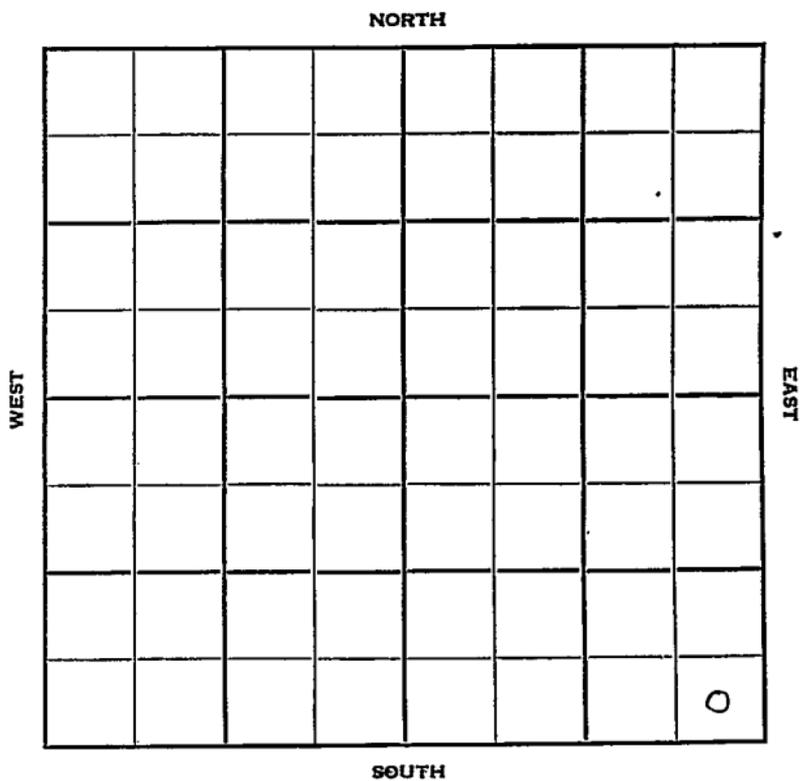

Stafford

KANSAS

Sec. 29 Twp. 21 R. 14 W

Well No. # 2 Lincoln Farm

Pet. Inc. Company

Garvey Contractor


_____ Ft. from N. Line

330 Ft. from S. Line

330 Ft. from E. Line

_____ Ft. from W. Line

SE SE SE

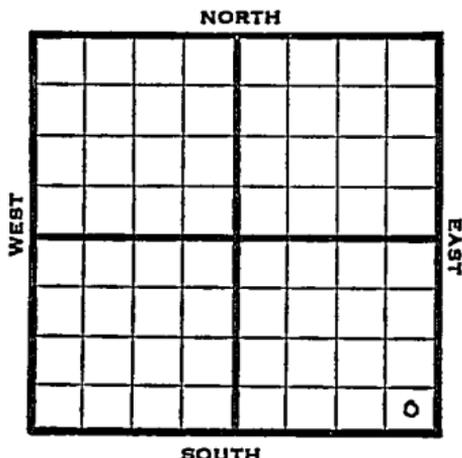

1951 Elev. 1945' REPORT

10/17 Spud 10-15-51
8" @ 253' WOC

12/12 Spud 10-15-51
Oil Well TD 3800
8" @ 253 Anhy 864
Heeb. 3294 Br lime 3411
Lans. 3421
DST 3538-53 opn 15 min
Rec. 270' oil
DST 3561-76 opn 1/2 hr
Rec. 40' vsocm
DST 3578-90 opn 45 min.
Rec 10' mud BKC 3649
Cong. 3694 Viola 3699 Simp sh 3740
Simp sd 3765 Arb. 3796 TD 3800
5" @ 3798 GO to 3800 10 gfph 30% oil
PB 360 19/3612-18 1000 A 5 boph
3000 A S/12 boph SP 3608 21/3582-92
1000 A 12 boph SP 3566 21/3542-52
FU 4 boph GO to 3650
Comp. 81 Bopd 10% wtr.

COMPLETED

