

Stafford

KANSAS

Section 29 Township 21 Range 14W

Well No. #1 Lincoln

Company Petroleum, Inc.

NORTH

WEST

EAST

SOUTH

Sec. 29 Twp. 21 R. 14 W

Well No. # 1 Lincoln Farm

Petroleum Inc. Company

Garvey Oil Contractor


Ft. from N. Line

990 Ft. from S. Line

990 Ft. from E. Line

Ft. from W. Line

NW SE SE

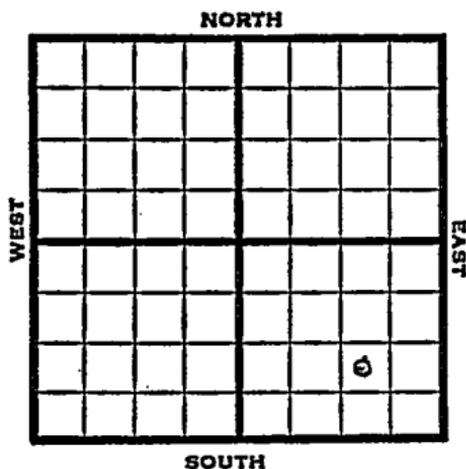

1951 Elev. 1945' REPORT

4/4 Spud 4-1-51
8" @ 257' WOC

5/16 Spud 4-1-51
Oil well TD 3849' 8" @ 257'
Heeb 3294' Br. lime 3412' Lans 3420'
DST 3540-51 open 20 min. rec 1390' gassy oil
DST 3564-94 open 1 hr. rec 240' HO & GCM
300' GCM, 60' water
DST 3608-25 open 1/2 hr. rec 75' HOCM
15' water
Cong. 3699' Viola: 3705' Simp. 3745'
Arb. 3799'
DST 3800-05' open 1 hr. rec 30' oil
25' HOCM, 10' water
TD 3849' 5" @ 3848' 4/3814-15
4 BWPB Perf/3799-3801 1 1/2 BO
2 1/4 BWPB SP 32/3543-51 5 1/2 BOPB
1000 A 23 BOPB
Comp. 1674 BOPD

COMPLETED

County Stafford State Kansas

Sec. 29 (Blk. 21 (Sur. 14W (Twp.) (Rge.) Map No.

Operator Petroleum Inc.

Well No. 1 Farm Lincoln

Elev. _____ Location NW SE SE

FIRST REPORT

990 Ft. From S Line SE

990 Ft. From E Line Quarter

Ist. Report APR 4 1951

Completion _____

Remarks _____

Garvey Oil - Contr.

Spudding Date 4-1-51

Drlg. Data _____

8" @ 257 WOC

J. E. TYRA

