

Sec. 29 Twp. 21 R. 14W

Well No. #3 Lincoln Farm

Petroleum Inc. Company

Contractor

Lincoln


 Ft. from N. Line

330 Ft. from S. Line

 Ft. from E. Line

1090 Ft. from W. Line

SE SW SE

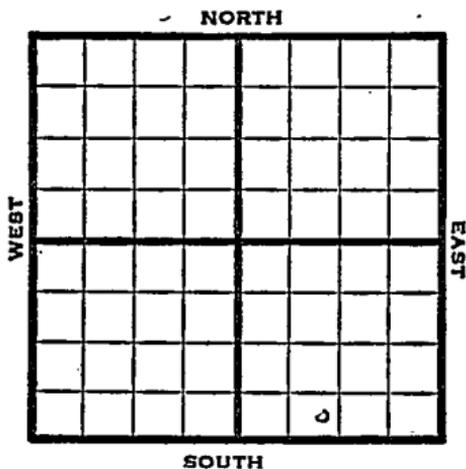

1951

Elv. 1948'

REPORT

11/14

Spud 11-9-51
8" @ 233'
Drlg. 1770'

1952
1/23

Spud 11-9-51
Oil Well TD 3810
8" @ 233
Anhy 874 Heeb. 3298
Br Line 3414 Lans. 3423
DST 3544-56 opn 20 min.
Rec. 60' mud & oil 480' free oil
Simp 3751 Arb. 3807
TD 3810 5" @ 3809
31/3547-57 250 A
Comp. 39 bopd 14% wtr.

COMPLETED

