

Stafford

KANSAS

SECTION 29 TOWNSHIP 21 RANGE 11 W

WELL NO. #2 Lincoln "A"

COMPANY Phillips Pet.

NORTH

						0	

WEST

EAST

SOUTH

Stafford

KANSAS


SEC.	TWP.	R.
29	21	### 14W

WELL NO. #2 Lincoln "A" FARM

COMPANY Phillips Pet.

CONTRACTOR

NW Lincoln
 990 Ft. from N. Line
 Ft. from S. Line
 988 Ft. from E. Line
 Ft. from W. Line

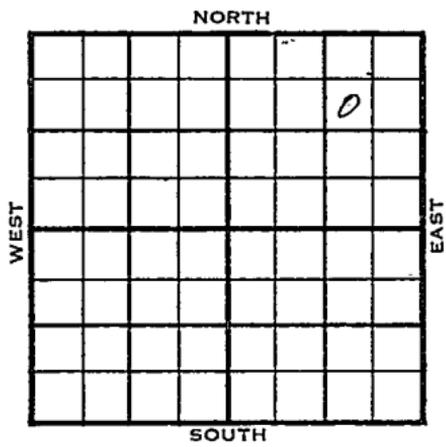

SW NE NE

SDX 1/4 mile

1956	ELEVATION	REPORT
	1945	

- 1-11 Location
- 1-19 Spud 1-14-56
9" @ 615/420
Drlg. 1937
- 1-26 Drlg. 3823
- 2-2 7" @ 3828/75
CO to 3810, 32/ 3760-68,
S/ 44 bo, 1 1/2 bw 2 hrs.
S/ 89 bo, 2.76 bw 1 3/4 hrs.
S/ 209 bo, 8 bw 13 hrs.
T & R
- 2-8 S/13.72 bo, .28 bw 1 hr., POP
- 2-16 P/ 240 bo, 19 bw 19 hrs.,
Waiting on ##### potential

County Stafford Elev. _____
 Sec. 29 Twp. 21 Rge. 11W
 Company Phillips Pet.
 Farm Name Lincoln "A" No. 2

Co.

TOPS	DEPTH	LOG.	DATUM	Loc. in Sec.
Anh.				SW NE NE
TP.				990' NL
H.				988' EL
Tr.				Geol. _____
Dg.				Contr. _____
BL.				
L.				
K.C.				
B.K.C.				Pool
Ce.				NW Lincoln
C.				
M.				
M.				
K.				
Mz.				
Mo.				
V.				
S.				
S.				
A.				
R.				
PE.				
G.				
T.D.				

Lse.

1/4 mile
JAN 11 '56
FIRST REPORT

No.

Sec.

T.

R.

Date Comm. _____
 Location _____

~~10~~

JAN 16 1956

R. G.

MAR 1 1956

R. G.

FEB 15 56 J. 240 Ba + 19 BW
in 19 from 110 Pat. FEB 22 56 X
Ph P #15 Bopp not with
SP PF. 3760-68
RTD 3830
PRTD 3810
graw 340