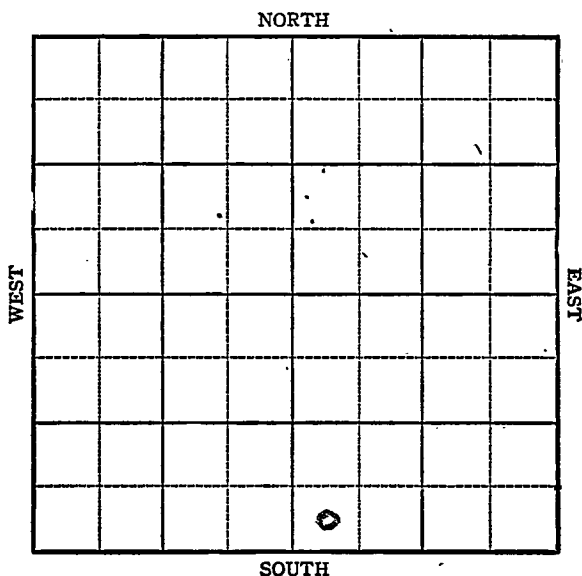


Stafford

KANSASSection 25 Township 21 Range 14WWell No. #1 Lincoln DukeCompany Lion Oil Ref.

KANSAS

Stafford

Sec. 29 Twp. 21 R. 14W

Well No. #1 Lincoln Duke Farm

Lion Oil Ref. Company

Wildcat

NORTH

 Ft. from N. Line

330 Ft. from S. Line

 Ft. from E. Line

330 Ft. from W. Line

WEST

EAST

SOUTH

Edw. 1947

1944

REPORT

7/26 Location

8/2 Rotaryl

8/9 Anhy 640

8" @ 640 Drlg. 2200

8/16 Lans 3440

Viola 3750

Simp 3827

Arb 3863

TD 3920

ABANDONED

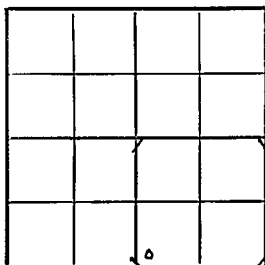
Pool Name Wildcat**KANSAS**Map No. 82 Sec. 29 Twp. 21 R. 14WWell No. 1 LincolnLion Oil Ref.

Company

FIRST REPORT

Contractor

SW SE

SECTION PLAT Ft. from N. Line330 Ft. from S. Line Ft. from E. Line330 Ft. from W. LineStafford CountyLocation XRig up

Drilling and Remarks:

RECORDCased in., ft.Sand Gas Oil Total Depth **PRODUCTION**1st 24 hrs. Nat. 1st 24 hrs. after shot Gas Cu. Ft.Dry Hole Abandoned

Date

JUL 26 1944 19S. J. LEWIS Scout

Pool Name Wildcat

KANSAS

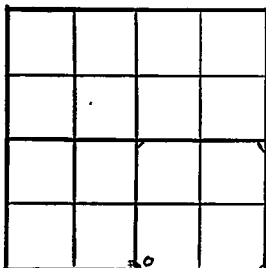
Map No. 8 Sec. 29 Twp. 21 R. 14WWell No. 1 Lincoln DukeLion Oil Ref. Company

CORRECTION

Contractor

SW SE

SECTION PLAT

 Ft. from N. Line330 Ft. from S. Line Ft. from E. Line330 Ft. from W. Line

Stafford County

Location Rig up

Drilling and Remarks:

Reported
#1 Lincoln

RECORD

Cased in. ft.Sand Gas Oil Total Depth

PRODUCTION

1st 24 hrs. Nat. 1st 24 hrs. after shot Gas Cu. Ft.Dry Hole Abandoned

Date

AUG 9 1944 19

S. J. LEWIS Scout

KANSAS

Pool Name WildcatMap No. 82 Sec. 29 Twp. 21 R. 14WWell No. 1 Lincoln DukeLion Oil Ref. Company

ABANDONED

Contractor

SW SE

SECTION PLAT

 Ft. from N. Line330 Ft. from S. Line Ft. from E. Line330 Ft. from W. LineStaffordLocation Rig up

Drilling and Remarks:

Lane 3440Viola 3750Smy 619827Cu 3863

RECORD

Cased in., ft.Sand Gas Oil Total Depth 3920

PRODUCTION

1st 24 hrs. Nat. 1st 24 hrs. after shot Gas Cu. Ft.Dry Hole Abandoned

Date

AUG 16 1944 19 S. J. LEWIS Scout