


Section 29 Township 21 Range 14WWell No. #1 WeirouchCompany Westgate Greenland

NORTH

WEST


EAST

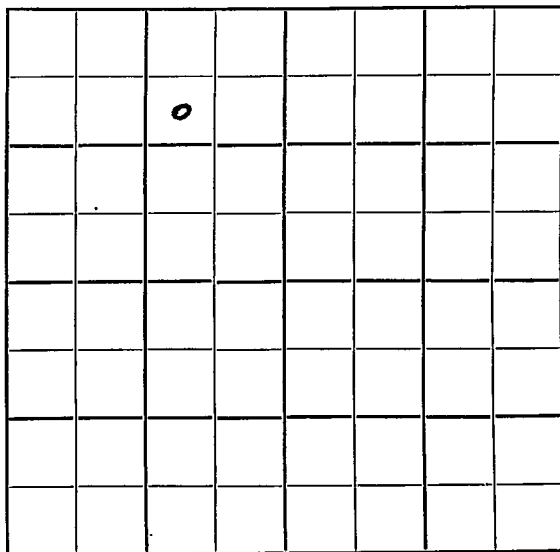

SOUTH

Sec. 29 Twp. 21 R. 14W ✓Well No. #1 Weirouch FarmWestgate-Greenland Company" Contractor
Wildcat990 Ft. from N. Line Ft. from S. Line990 Ft. from E. Line Ft. from W. Line

SW NE NW

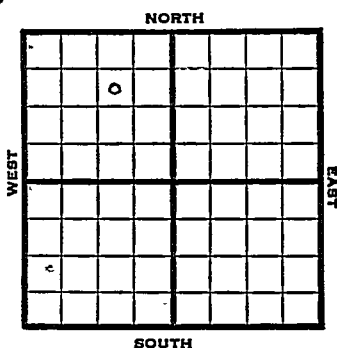

1952 Elev. 1944' REPORT

10/15 RUR

10/22 7" @ 247 Drlg. 3298'

10/29 Heeb 3288, Tor 3315, B. Oread 3327,
Br li 3401, Lans 3412
DST 3545-59, 1 hr., 30' SOCM
BKC 3646, V 3676, Simp 3718
DST 3735-64, 1 hr., 35' M
Arb 3778
DST 3780-88, 1 hr., 950' clean oil
900#
DST 3788-98 1 hr., 2355' SOCSulphwtr
RTD 3817'?

11/5 5" @
5" @ 3817'
36/3782-85, 47/3777-82, S/61
BO + 5% wtr 8 hrs., POP

11/12 NR

11/20 "

11/26 Spud 10-18-52

Oil Well

TD 3817'

7" @ 247'

Heeb 3288, Tor 3315, B Oread
3327, Br lime 3401, Lans 3412
DST 3545-59, opn 1 hr., rec.

OVER


(Information Brought Forward)

1952

11/26

30' socm
B KC 3646, Viola 3676, Simp
3718,
DST 3735-64, opn 1 hr., rec.
35' mud
Arb 3778
DST 3780-88, opn 1 hr., rec.
950' clean oil 900#
DST 3788-98, opn 1 hr., rec.
2355' soc sul. wtr.
TD 3817
5" @ 3817
36/3782-85, 47/3777-82, S/61
bo 5 % wtr.,
Comp. 213 bopd 11% wtr.

COMPLETED.

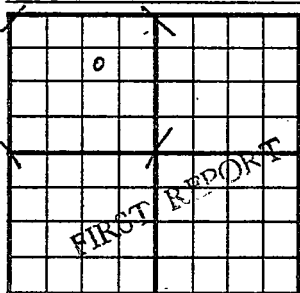County Stafford State KansasSec. 29 (Blk. Twp.) 21 (Sur. Rge.) 14W Map No.Operator Westgate-GreenlandWell No. 1 Farm WeirouchElev. Location SW NE NW990 Ft. From N Line NW990 Ft. From E Line Quarter1st. Report OCT 15 1957

Completion

Remarks

Westgate-Greenland - Contr.

Spudding Date

Drig. Data WildcatR U R

J. G. McGEHEE

Scout Cards

Land Small Map

Land Wall Map

Tracings

Franca Map

Pierce Map

Misc.

2361 02 120

Orig. Data

County	Stafford		State	Kansas	
Sec.	29	(Blk.) (Twp.)	21	(Sur.) (Rge.)	14W Map No.
Operator	Westgate-Greenland				
Well No.	1	Farm	Weirouch		
Elev.	1944	Location	SW NE NW		

	0					

990 Ft. From N Line NW

990 Ft. From E Line Quarter

1st. Report

Completion NOV 26 1952

Remarks Wildcat

Westgate-Greenland - Contr

Spudding Date 10-18-52

Drlg. Data Oil well TD 3817

7" @ 247 Heeb. 3288 Tor. 3315

B. Oread 3327 Br. lime 3401 Lans. 3412

DST 3545-59 open 1 hr. Rec. 30' socm

B KC 3646 Viola 3676 Simp. 3718

DST 3735-64 open 1 hr. Rec. 35' mud

Arb. 3778 DST 3780-88 open 1 hr.

Rec. 950' clean oil 900# DST 3788-98

open 1 hr. Rec. 2355' soc sul. wtr.

TD 3817 5" @ 3817 36/ 3782-85

47/ 3777-82 S/ 61 bo 5% wtr.

Comp. 213 bopd 11% wtr.

J. G. McGEHEE

Scout Cards	110
Land Small Map	
Land Wall Map	47
Tracings	
France Map	
Pierce Map	
Misc.	

DEC 4 1952